

Perry  
 J17.  
 1-20-69

MISSISSIPPI  
 BOARD OF WATER COMMISSIONERS  
 416 North State Street  
 Jackson, Mississippi 39201

WATER WELL DRILLERS LOG

CODED  
 Perry  
 Forrest

January 20, 1969 date well completed  
 Time Drilling Service firm name  
 Forrest county well located

LANDOWNER:  
 Dewitt Byrd  
 Beaumont, Miss.  
 (mailing address)

description of formations encountered	from	to
Red Clay	0	8
Clay Gravel	8	16
Walter Bearing Sand	16	40
Blue Clay	40	150
Sand	150	194
Clay	194	320
Sand	320	380
Clay	380	406
Sand	406	427

WELL LOCATION:  
 sec. 27 T 30 N R 9 E  
 S W  
 B miles NE of Beaumont  
 (distance) (direction) (nearest town)

WELL PURPOSE: home  
 (home, irrigation, municipal, industrial)

WELL COMPLETION DATA:

(1) diameter (inches) 2"

(2) total depth (feet) 477

(3) static water level (feet) flow below top of ground. above

(4) casing galv. 466 (material) (depth)

(size) if telescope see back.

(5) screen 10' 466 (length) (depth to top)

2" Stainless Steel (size) (material)

(6) pump None 40 (HP) (yield gpm)

None (type power)

(7) electric log No (yes or no)

(organization running log)

(8) how well bottom plugged Valve

CODED


MAR 25 1969

DRILLERS REMARKS:

MISS. Bd. of WATER  
 Total Depth 477

If well telescopes please sketch and show depths.

GROUND LEVEL

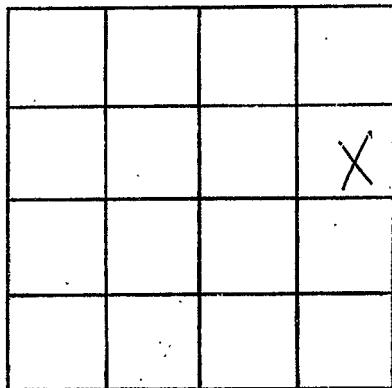

SECTION 21

Please indicate well location X.

ADDITIONAL INFORMATION

If more than one screen,  
show locations of each on sketch.