

PERRY  
 8 18  
 2-15-69

MISSISSIPPI  
 BOARD OF WATER COMMISSIONERS  
 416 North State Street  
 Jackson, Mississippi 39201

CODED

WATER WELL DRILLERS LOG

PERRY  
 Forrest

Feb. 15 1969 Jim Drill. Ser. date well completed firm name county well located

LANDOWNER:  
 J.D. Sylvester  
 Beaumont, Miss.  
 (mailing address)

description of formations encountered	from	to
Red Clay	0	18
Sand	18	40
Blue Clay	40	160
Blue Sand	160	184
Blue Clay + Shell	184	306
Sand	306	328
Clay - Shale	328	514
Sand	514	575

WELL LOCATION:  
 sec. 26 T. 30 N. R. 9 E. S. 1 W.  
 2 miles E of Arlington  
 (distance) (direction) (nearest town)

WELL PURPOSE: none  
 (home, irrigation, municipal, industrial)

WELL COMPLETION DATA:

(1) diameter (inches) 2"

(2) total depth (feet)

(3) static water level (feet) flow below top of ground.

(4) casing galv. 565'  
 (material) (depth)

if telescope see back.  
 (size)

(5) screen 18' 565'  
 (length) (depth to top)  
 2" (size) stainless steel (material)

(6) pump none 40  
 (HP) (yield gpm)

None (type power)

(7) electric log No  
 (yes or no)

(organization running log)

(8) how well bottom plugged Value

CODED

MAR 25 1969


DRILLERS REMARKS:

total Depth 575'

MISS. BD. OF  
 WATER COMMISSIONERS

If well telescopes please sketch and show depths.

GROUND LEVEL

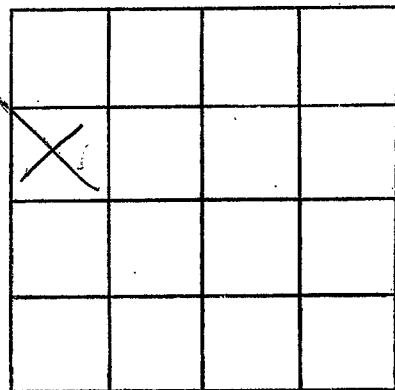

SECTION 26

Please indicate well location X.

ADDITIONAL INFORMATION

If more than one screen, show locations of each on sketch.