

Perry
 9 19
 11-12-69

MISSISSIPPI
 BOARD OF WATER COMMISSIONERS
 416 North State Street
 Jackson, Mississippi 39201

CODED
 CODED

WATER WELL DRILLERS LOG


11-12 1969 *S&R* *Perry*
 date well completed firm name county well located

LANDOWNER: <i>Dennis Lett</i>	description of formations encountered	from	to
<i>pt 1</i>	<i>Sand clay</i>	<i>0</i>	<i>6</i>
<i>Beaman Miss.</i> (mailing address)	<i>hard sand</i>	<i>6</i>	<i>16</i>
WELL LOCATION:	<i>CW to Sand</i>	<i>16</i>	<i>28</i>
sec <i>28</i> T <i>3</i> N <i>9</i> R <i>9</i> E <i>W</i> S W			
<i>2</i> miles <i>N</i> of <i>Beaman</i> (distance) (direction) (nearest town)			
WELL PURPOSE: <i>Home</i> (home, irrigation, municipal, industrial)			
WELL COMPLETION DATA:			
(1) diameter (inches) <i>2"</i>			
(2) total depth (feet) <i>38</i>			
(3) static water level (feet) <i>18</i> below above top of ground.			
(4) casing <i>plastic</i> <i>53</i> (material) (depth)			
<i>2"</i> (size) if telescope see back.			
(5) screen <i>5</i> <i>33</i> (length) (depth to top)			
<i>2"</i> (size) <i>plastic</i> (material)			
(6) pump <i>3/4</i> <i>1200h.</i> (HP) (yield gpm)			
<i>let</i> (type power)			
(7) electric log _____ (yes or no)			
_____ (organization running log)			
(8) how well bottom plugged <i>None</i>			
DRILLERS REMARKS:			

DEC 23 1969
 MISS. DEPT. OF
 WATER RESOURCES

If well telescopes please sketch and show depths.

GROUND LEVEL

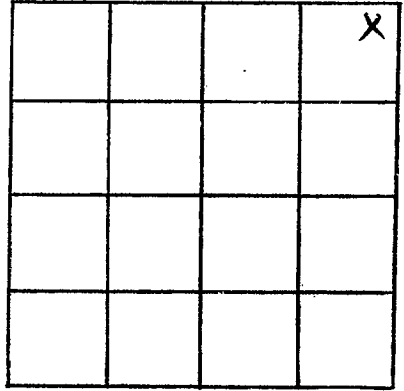

SECTION 28

Please indicate well location X.

ADDITIONAL INFORMATION

If more than one screen,
show locations of each on sketch.