

MISSISSIPPI
BOARD OF WATER COMMISSIONERS
416 North State Street
Jackson, Mississippi 39201

CODED

WATER WELL DRILLERS LOG

Perry
J20
2-28-70

Feb 28, 1970 date well completed
Cochran & Rayburn, Drillers firm name
Perry county well located

LANDOWNER: Mr. A. P. Lee
Beaumont, MS

description of formations encountered

from to

<u>Sandy Clay</u>	<u>0</u>	<u>12</u>
<u>Red Sand & Clay</u>	<u>12</u>	<u>22</u>
<u>Blue Clay</u>	<u>22</u>	<u>44</u>
<u>Gray Clay</u>	<u>44</u>	<u>62</u>
<u>Shale & Clay</u>	<u>62</u>	<u>76</u>
<u>Blue Clay</u>	<u>76</u>	<u>91</u>
<u>Sand</u>	<u>91</u>	<u>130</u>

(mailing address)

WELL LOCATION:

sec 26 T 3 (N) R 9 E
S (W)
3 1/2 miles N-E of Beaumont
(distance) (direction) (nearest town)

WELL PURPOSE: home
(home, irrigation, municipal, industrial)

WELL COMPLETION DATA:

- diameter (inches) 7
- total depth (feet) 130
- static water level (feet) 68 below above top of ground.
- casing PVC, 125,
(material) (depth)
(size) if telescope see back.
- screen 5, 125
(length) (depth to top)
2, PVC
(size) (material)
- pump 1 1/2, 6 1/2
(HP) (yield gpm)
Ele.
(type power)
- electric log No
(yes or no)

(organization running log)

(8) how well bottom plugged Water

DRILLERS REMARKS:

J. Ernest Cochran


CODED

MAR 6 - 1970

MISS. BD. OF
WATER COMM.

If well telescopes please sketch and show depths.

GROUND LEVEL

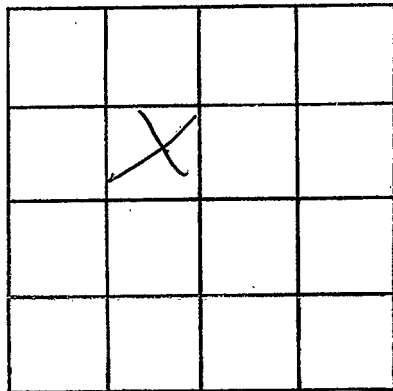

SECTION 26

Please indicate well location X.

ADDITIONAL INFORMATION

If more than one screen, show locations of each on sketch.