

Perry Co  
J 21

MISSISSIPPI  
BOARD OF WATER COMMISSIONERS  
416 North State Street  
Jackson, Mississippi 39201

WATER WELL DRILLERS LOG

date well completed 19 70 June Drilling firm name Perry county well located

LANDOWNER:

Buck Shanks

description of formations encountered

from

to

Pt. 1. Beaumont

(mailing address)

clay  
sand

0 <60  
40 92

WELL LOCATION:

116

sec. 8 T. 3 N R. 9 E  
5 miles N of Beaumont  
(distance) (direction) (nearest town)

WELL PURPOSE: home  
(home, irrigation, municipal, industrial)

WELL COMPLETION DATA:


- (1) diameter (inches) 2 in.
- (2) total depth (feet) 92
- (3) static water level (feet) 50 below above top of ground.
- (4) casing plastic, 57  
(material) (depth)  
       if telescope see back.  
(size)
- (5) screen 5, 57  
(length) (depth to top)  
2 in., plastic  
(size) (material)
- (6) pump 1/2, 4  
(HP) (yield gpm)  
electric  
(type power)
- (7) electric log No  
(yes or no)
- (organization running log)

(8) how well bottom plugged SP. Jakes

DRILLERS REMARKS:

If well telescopes please sketch and show depths.

GROUND LEVEL

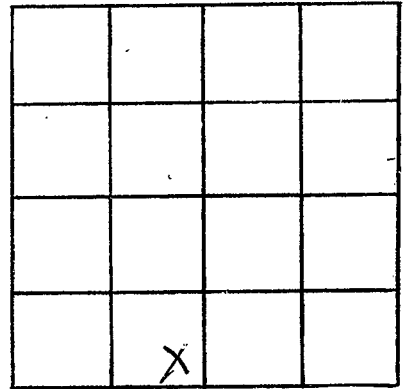

SECTION 8

Please indicate well location X.

ADDITIONAL INFORMATION

Lined area for additional information.

If more than one screen, show locations of each on sketch.