

PERRY  
J22  
8-25-70

MISSISSIPPI  
BOARD OF WATER COMMISSIONERS  
416 North State Street  
Jackson, Mississippi 39201

**CODED**

WATER WELL DRILLERS LOG

8/25 1970 SFR Perry  
date well completed firm name county well located

LANDOWNER: Jimmy Lee  
Rt. 1  
Beaumont, Miss.  
(mailing address)

WELL LOCATION:  
sec 35 T 3 S R 9 E  
4 miles E of Beaumont  
(distance) (direction) (nearest town)

WELL PURPOSE: home  
(home, irrigation, municipal, industrial)

- WELL COMPLETION DATA:
- (1) diameter (inches) 2 in.
  - (2) total depth (feet) 125 ft.
  - (3) static water level (feet) 82 below above top of ground.
  - (4) casing plastic, 115 ft. (material) (depth)
  - 2 in. (size) if telescope see back.
  - (5) screen 115 ft. (length) (depth to top)
  - 2 in. plastic (size) (material)
  - (6) pump 1 (HP) 420 gpm (yield gpm)
  - Jet (type power)
  - (7) electric log (yes or no)
  - (organization running log)
  - (8) how well bottom plugged Valve

description of formations encountered	from	to
red clay	0	8
red sand	8	21
pink clay	21	32
part. clay	32	40
yellow clay	40	62
clay	62	82
part. clay	82	90
fin sand	90	110
CWB sand	110	125


**CODED**

DRILLERS REMARKS:

OCT 12 1970

If well telescopes please sketch and show depths.

GROUND LEVEL

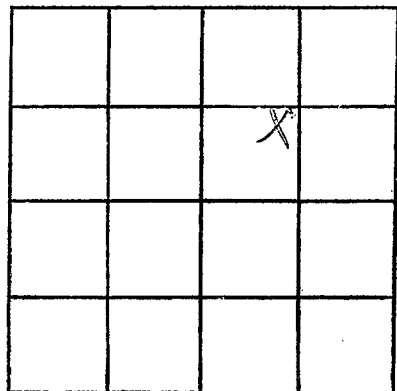

SECTION 35

Please indicate well location X.

ADDITIONAL INFORMATION

If more than one screen, show locations of each on sketch.