

MISSISSIPPI
BOARD OF WATER COMMISSIONERS
416 North State Street
Jackson, Mississippi 39201

CODED

WATER WELL DRILLERS LOG

PERRY
J 23
7-15-70

July 15 1970 Tina Drilling Perry
date well completed firm name county well located

LANDOWNER: Jim
Mr. Donald
P.O. Beaumont Miss.
(mailing address)

description of formations encountered	from	to
<u>Sandy Clay</u>	<u>0</u>	<u>15</u>
<u>Blue clay</u>	<u>15</u>	<u>25</u>
<u>Blue clay</u>	<u>25</u>	<u>27.5</u>
<u>Clay & shale</u>	<u>27.5</u>	<u>410</u>
<u>Blue sand</u>	<u>410</u>	<u>450</u>
<u>sand & black gravel</u>	<u>450</u>	<u>468</u>
<u>sand</u>	<u>468</u>	<u>492</u>

WELL LOCATION:
sec. 19 T 3 N R 9 E
2 miles North of Beaumont
(distance) (direction) (nearest town)

WELL PURPOSE: Home
(home, irrigation, municipal, industrial)

WELL COMPLETION DATA:
(1) diameter (inches) 2 in.
(2) total depth (feet) 492 ft.
(3) static water level (feet) 20 below above top of ground.
(4) casing galv. 492 ft.
(material) (depth)
no if telescope see back.
(size)
(5) screen 10 ft. 482
(length) (depth to top)
2 in. steel
(size) (material)
(6) pump none
(HP) (yield gpm)

CODED

(7) electric log no
(yes or no)
(organization running log)
(8) how well bottom plugged B.P.
none

AUG 5 1970


MISS. DEPT. OF WATER COMM.

MISS. DEPT. OF WATER COMM.

DRILLERS REMARKS:

If well telescopes please sketch and show depths.

GROUND LEVEL

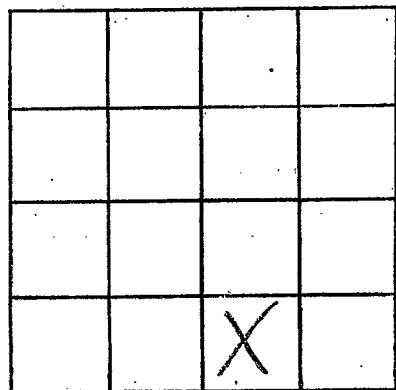

SECTION 17

Please indicate well location X.

ADDITIONAL INFORMATION

If more than one screen, show locations of each on sketch.