

MISSISSIPPI
BOARD OF WATER COMMISSIONERS
416 North State Street
Jackson, Mississippi 39201

CODED

WATER WELL DRILLERS LOG

PERRY
J 24
7-17-70

July 17 1970 Time Billing Service Perry
date well completed firm name county well located

LANDOWNER: Moldy

description of formations encountered from to

Qt. 1 Beaumont
(mailing address)

Clay	0	15
Sand	15	30
Blue Clay	30	280
Blue Clay with ls	280	390
Sand	390	492

WELL LOCATION:
sec. 20 T 3 N R 9 E
1/2 miles North of Beaumont
(distance) (direction) (nearest town)

WELL PURPOSE: Home
(home, irrigation, municipal, industrial)

WELL COMPLETION DATA:

- (1) diameter (inches) 2 in.
- (2) total depth (feet) 492 ft
- (3) static water level (feet) 20 below top of ground.
- (4) casing galv. 482
(material) (depth)
- no if telescope see back.
(size)
- (5) screen 10 ft. 482
(length) (depth to top)
- 2 in. stainless steel
(size) (material)
- (6) pump none
(HP) (yield gpm)
- (type power)
- (7) electric log no
(yes or no)
- (organization running log)
- (8) how well bottom plugged B.P.

CODED


DRILLERS REMARKS:

AUG 23 1970

MISS. BO. OF
WATER COMM.

If well telescopes please sketch and show depths.

GROUND LEVEL

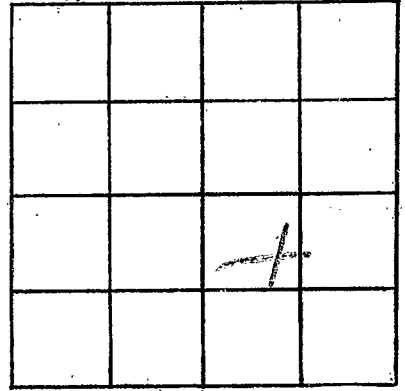

SECTION 20

Please indicate well location X.

ADDITIONAL INFORMATION

If more than one screen,
show locations of each on sketch.