

E LOG # 114

MISSISSIPPI
BOARD OF WATER COMMISSIONERS
416 North State Street
Jackson, Mississippi 39201

CODED

WATER WELL DRILLERS LOG

PERRY
J 26
5-5-71

5/5 1971 date well completed
S.H. firm name
Perry county well located

LANDOWNER: Miss Agricultural
E. Expremier Station
Monticello Miss
(mailing address)

description of formations encountered	from	to
Reddy Clay	0	12
White Sand	12	32
Red Sand	32	64
White Sand	64	82
Red + Sand	82	92
P.W.B. Sand	92	129

WELL LOCATION:
sec 8 T 3 N R 9 E
S W
2 miles S of Monticello
(distance) (direction) (nearest town)

WELL PURPOSE:
(home, irrigation, municipal, industrial)

- WELL COMPLETION DATA:
- (1) diameter (inches) 2"
 - (2) total depth (feet) 129
 - (3) static water level (feet) 59 below top of ground
 - (4) casing plastic 113 (material) (depth)
2" (size) if telescope see back.
 - (5) screen 10 113 (length) (depth to top)
2" (size) plastic (material)
 - (6) pump 1 660 G.P.M. (HP) (yield gpm)
Just (type power)
 - (7) electric log Yes (yes or no)
Miss AS (organization running log)
 - (8) how well bottom plugged None

CODED


MAY 18 1971

DRILLERS REMARKS:

MISS. BD. OF
WATER COM.

If well telescopes please sketch and show depths.

GROUND LEVEL

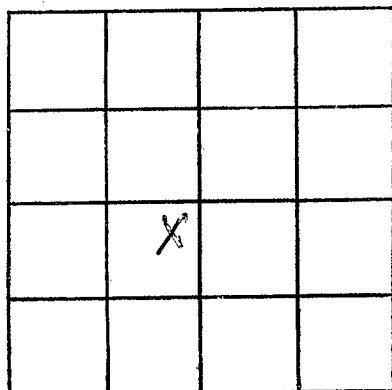

SECTION 8

Please indicate well location X.

ADDITIONAL INFORMATION

If more than one screen, show locations of each on sketch.