

PERRY
J28
4-28-72

MISSISSIPPI BOARD OF WATER COMMISSIONERS
416 North State Street
Jackson, Mississippi 39201

CODED

WATER WELL DRILLERS LOG

April 28 1972 Cochran Drilling Service Perry
date well completed firm name county well located

LANDOWNER:	description of formations encountered	from	to
James Pipkins Beaumont Miss. (mailing address)	Top soil	0	3
	Red clay	3	18
	Sand	18	25
	Clay Brown	25	126
	Clay white	126	241
	S shale	241	394
	Blue clay	394	484
	Sand	484	530
WELL LOCATION: sec 36 T 3 N R 9 E S 4 W 4 1/2 miles NE of Beaumont (distance) (direction) (nearest town)			
WELL PURPOSE: home (home, irrigation, municipal, industrial)			
WELL COMPLETION DATA:			
(1) diameter (inches) 2			
(2) total depth (feet) 530			
(3) static water level (feet) flows below top of ground.			
(4) casing P.V.C. 520 (material) (depth)			
(size) if telescope see back.			
(5) screen 10 520 (length) (depth to top)			
(size) (material)			
(6) pump 30 flows (HP) (yield gpm)			
(type power)			
(7) electric log no (yes or no)			
(organization running log)			
(8) how well bottom plugged Valve			
DRILLERS REMARKS:			


CODED

MAY 9 - 1972

MISS. Bd. OF WATER COMMISSIONERS

If well telescopes please sketch and show depths.

GROUND LEVEL

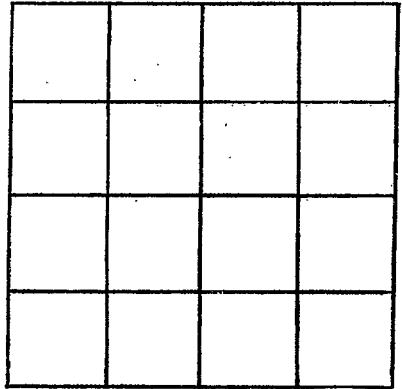

SECTION _____

Please indicate well location X.

ADDITIONAL INFORMATION

A series of horizontal lines for entering additional information, located below the 'ADDITIONAL INFORMATION' header.

If more than one screen, show locations of each on sketch.