

PERRY
J 30
4-13-72

MISSISSIPPI
BOARD OF WATER COMMISSIONERS
416 North State Street
Jackson, Mississippi 39201

CODED

WATER WELL DRILLERS LOG

H-13 1972 *Roberts* Perry
date well completed firm name county well located

LANDOWNER: *Right plot farm*
HW 15 SA
Wichita, Miss
(mailing address)

description of formations encountered	from	to
<i>Sand Clay</i>	<i>0</i>	<i>21</i>
<i>Fine Red Sand</i>	<i>21</i>	<i>27</i>
<i>Pink Clay</i>	<i>27</i>	<i>35</i>
<i>P. Sand & Silt</i>	<i>35</i>	<i>130</i>

WELL LOCATION:
sec. 5 T. 3 N. R. 9 E
miles of *Antioch*
(distance) (direction) (nearest town)

WELL PURPOSE:
(home, irrigation, municipal, industrial)

WELL COMPLETION DATA:

- (1) diameter (inches) ~~4~~ *4"*
- (2) total depth (feet) *130*
- (3) static water level (feet) *90* below above top of ground.
- (4) casing *PVC*, *120*,
(material) (depth)
4" if telescope see back.
(size)
- (5) screen *10*, *120*
(length) (depth to top)
4, *PVC*
(size) (material)
- (6) pump *1*, *570 G.P.M.*
(HP) (yield gpm)
1/2
(type power)
- (7) electric log _____
(yes or no)

(organization running log)
- (8) how well bottom plugged *None*

CODED


SEP 28 1972

MISS. DIV. OF
WATER RESOURCES

DRILLERS REMARKS:

If well telescopes please sketch and show depths.

GROUND LEVEL

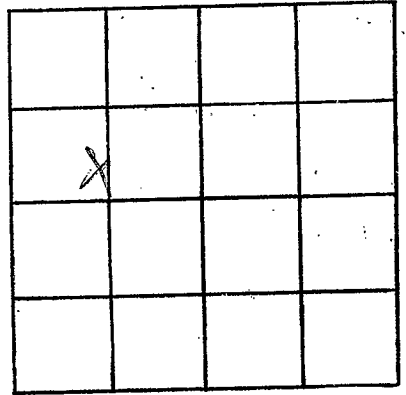

SECTION 5

Please indicate well location X.

ADDITIONAL INFORMATION

If more than one screen,
show locations of each on sketch.