

PERRY
J 33
11-3-72

MISSISSIPPI
BOARD OF WATER COMMISSIONERS
416 North State Street
Jackson, Mississippi 39201

WATER WELL DRILLERS LOG

11-3-72 date well completed 1972 Juvon Wells Drilling Co firm name Perry county well located

LANDOWNER	description of formations encountered	from	to
Juvon Curvey			
R. P. H.	Clay	0	44
Richter Miss (mailing address)	Sand	44	46

WELL LOCATION:
sec. 4 T. 3 N. R. 9 E.
1.5 miles S.E. of Supton (distance) (direction) (nearest town)

WELL PURPOSE: rock (home, irrigation, municipal, industrial)


- WELL COMPLETION DATA:
- (1) diameter (inches) 2 1/2"
 - (2) total depth (feet) 500
 - (3) static water level (feet) 295 below top of ground
 - (4) casing (material) Plastic, (depth) 485
 - 2 1/2" (size) If telescope see back.
 - (5) screen 15 ft (length), 500 ft (depth to top)
 - 2 1/2" (size), Plastic (material)
 - (6) pump (HP) (yield gpm)
 - (type power)
 - (7) electric log (yes or no)
 - (organization running log)

(8) how well bottom plugged	Value		
DRILLERS REMARKS:			

NOV 20 1972

If well telescopes please sketch and show depths.

GROUND LEVEL

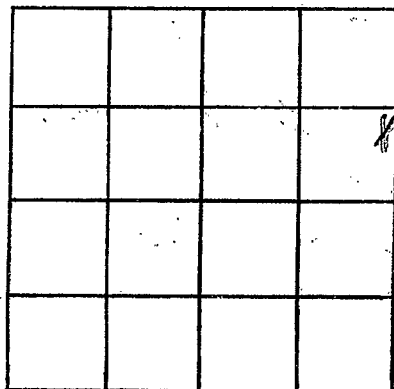

SECTION _____

Please indicate well location X.

ADDITIONAL INFORMATION

If more than one screen,
show locations of each on sketch.