

Perry  
J 34  
4-12-73

MISSISSIPPI  
BOARD OF WATER COMMISSIONERS  
416 North State Street  
Jackson, Mississippi 39201

**CODED**

WATER WELL DRILLERS LOG

4-12-1973 date well completed  
Cochran Drilling Service firm name  
Perry county well located

LANDOWNER: Samgo Hinton  
Route 4 Richton  
(mailing address)

WELL LOCATION:  
sec. 2 T 3 N R 9 E  
S W  
7 miles east of Hintonville  
(distance) (direction) (nearest town)

WELL PURPOSE: Home  
(home, irrigation, municipal, industrial)

WELL COMPLETION DATA:

(1) diameter (inches) 2"

(2) total depth (feet) 425'

(3) static water level (feet) 6  below  above top of ground.

(4) casing P.V.C., 415'  
(material) (depth)

\_\_\_\_\_ if telescope see back.  
(size)

(5) screen 10', 415'  
(length) (depth to top)

2", P.V.C.  
(size) (material)

(6) pump 1 6  
(HP) (yield gpm)

Electric  
(type power)

(7) electric log no  
(yes or no)

\_\_\_\_\_ (organization running log)

(8) how well bottom plugged value

description of formations encountered	from	to
Top soil	0	2
red clay	2	5
gray clay	5	31
blue clay	31	42
blue clay	42	154
gray clay	154	189
shale	189	205
blue clay	205	388
sand	388	425

**CODED**


JUN 10 1973

DRILLERS REMARKS:

MISS. BD. OF  
WATER COMMISSIONERS

If well telescopes please sketch and show depths.

GROUND LEVEL

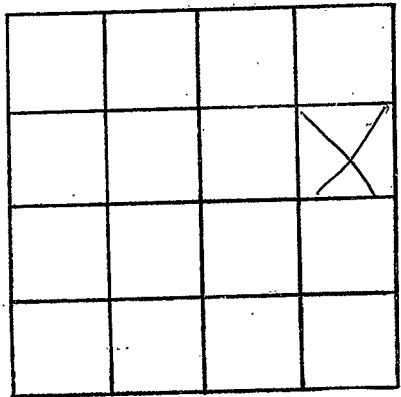

SECTION 2

Please indicate well location X.

ADDITIONAL INFORMATION

Lined area for additional information.

If more than one screen, show locations of each on sketch.