

MISSISSIPPI
BOARD OF WATER COMMISSIONERS
416 North State Street
Jackson, Mississippi 39201

CODED

WATER WELL DRILLERS LOG

Perry
J 35
5-15-73

5-15 1973 Cochran Drilling Service Perry
date well completed firm name county well located

LANDOWNER: J. A. Thomas
Beaumont

description of formations encountered	from	to
Top soil	0	2
Red clay	2	22
sand	22	158
gray clay	158	239
shale	239	267
Blue clay	267	421
sand	421	490

(mailing address)

WELL LOCATION:
sec 28 T 3 N R 9 E
S W
2 1/2 miles NE of Beaumont
(distance) (direction) (nearest town)

WELL PURPOSE: Home
(home, irrigation, municipal, industrial)

WELL COMPLETION DATA:

(1) diameter (inches) 2"

(2) total depth (feet) 490'

(3) static water level (feet) below top of ground. above

(4) casing PVC 490'
(material) (depth)

 If telescope see back.
(size)

(5) screen 10' 480'
(length) (depth to top)

 (size) (material)

(6) pump (HP) (yield gpm)

 (type power)

(7) electric log NO
(yes or no)

 (organization running log)

(8) how well bottom plugged Water


CODED

DRILLERS REMARKS:

JUN 18 1973

If well telescopes please sketch and show depths.

GROUND LEVEL

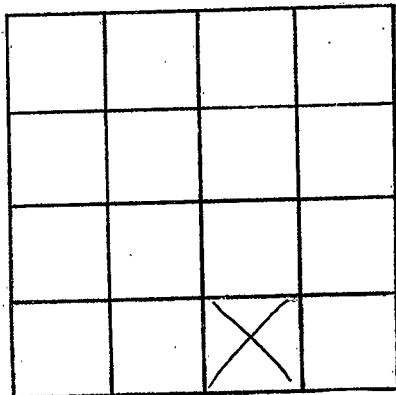

SECTION 28

Please indicate well location X.

ADDITIONAL INFORMATION

Lined area for additional information.

If more than one screen, show locations of each on sketch.