

MISSISSIPPI
BOARD OF WATER COMMISSIONERS
416 North State Street
Jackson, Mississippi 39201

CODED

WATER WELL DRILLERS LOG

Perry
J 36
5-25-73

5-25 1973 Cochran Drilling Service Perry
date well completed firm name county well located

LANDOWNER: Fair Hope Register
Beaumont Nearta
choice

(mailing address)

WELL LOCATION:
sec. 26 T. 3 N. R. 9 E. W
4 miles N.E. of Beaumont
(distance) (direction) (nearest town)

WELL PURPOSE: Home
(home, irrigation, municipal, industrial)

WELL COMPLETION DATA:

- (1) diameter (inches) 2 1/2"
- (2) total depth (feet) 94'
- (3) static water level (feet) 32' below above top of ground.
- (4) casing PVC 89'
(material) (depth)
- _____ if telescope see back.
(size)
- (5) screen 5' 89'
(length) (depth to top)
- 2 1/2" PVC
(size) (material)
- (6) pump 1 5 1/2
(HP) (yield gpm)
- Electric
(type power)
- (7) electric log no
(yes or no)
- _____ (organization running log)
- (8) how well bottom plugged no

description of formations encountered	from	to
Top soil	0	3
Red clay	3	5
red sand	5	11
brown clay	11	27
gray clay	27	39
blue clay	39	73
Sand	73	94

CODED


MISSISSIPPI
BOARD OF WATER COMMISSIONERS

WATER
COMMISSION

DRILLERS REMARKS:

If well telescopes please sketch and show depths.

GROUND LEVEL

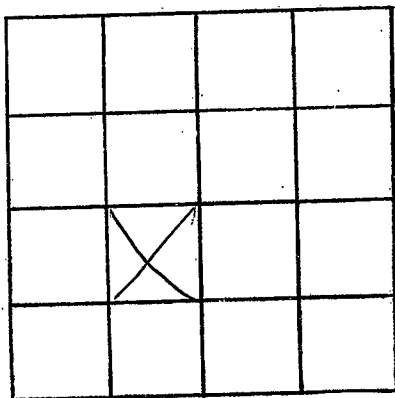

SECTION 26

Please indicate well location X.

ADDITIONAL INFORMATION

Lined area for additional information.

If more than one screen, show locations of each on sketch.