

Perry
J39
8-4-73

416 North State Street
Jackson, Mississippi 39201

WATER WELL DRILLERS LOG

CODED

8-4 date well completed 1973 firm name *Small Drilling Co* Perry county well located

LANDOWNER: *R.F. D. I*
R.F. D. I
(mailing address)

description of formations encountered	from	to
<i>Sand</i>	<i>0</i>	<i>40</i>
<i>Sand & Gravel</i>	<i>40</i>	<i>73</i>
<i>Sticky clay</i>	<i>73</i>	<i>86</i>
<i>Old man at bed</i>	<i>86</i>	<i>105</i>

WELL LOCATION:
sec. *4* T *3* N R *9* E S W
6 miles *N* of *Perry*
(distance) (direction) (nearest town)

WELL PURPOSE: *drinking*
(home, irrigation, municipal, industrial)

WELL COMPLETION DATA:
(1) diameter (inches) *2"*
(2) total depth (feet) *105 ft*
(3) static water level (feet) *21 ft* below top of ground.
(4) casing *Plastic, 100 ft*
(material) (depth)
2"
(size) If telescope see back.
(5) screen *5 ft*, *105 ft*
(length) (depth to top)
2", *Plastic*
(size) (material)
(6) pump *1/2*, *450 gpm*
(HP) (yield gpm)
jet
(type power)
(7) electric log
(yes or no)
(organization running log)
(8) how well bottom plugged *Water*


CODED

DRILLERS REMARKS:

100 9/19/73

and snow depths.

GROUND LEVEL

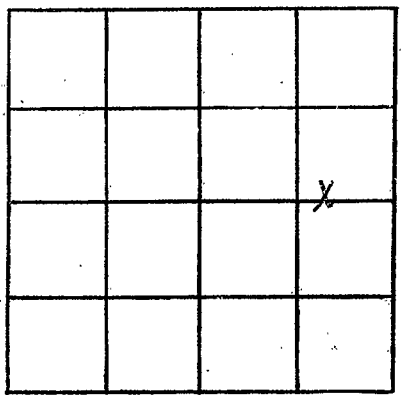

SECTION _____

Please indicate well location X.

ADDITIONAL INFORMATION

Lined area for providing additional information.

If more than one screen,
show locations of each on sketch.