

Perry  
 J 40  
 7-22-73

MISSISSIPPI  
 BOARD OF WATER COMMISSIONERS  
 416 North State Street  
 Jackson, Mississippi 39201

**CODED**

WATER WELL DRILLERS LOG

July 22 1973 Cochran Drillers Perry  
 date well completed firm name county well located

LANDOWNER:  
 Henry Ray Bolton  
 Rt. 1, Beaumont  
 (mailing address)

description of formations encountered	from	to
Top Soil	0	2
red clay	2	8
brown clay	8	16
gray clay	16	27
red sand	27	39
sand	39	50

WELL LOCATION:  
 sec. 30 T 3 N R 9 E S W  
 3 miles north of Beaumont  
 (distance) (direction) (nearest town)

WELL PURPOSE: home  
 (home, irrigation, municipal, industrial)

**CODED**


- WELL COMPLETION DATA:
- (1) diameter (inches) 2 1/2
  - (2) total depth (feet) 52'
  - (3) static water level (feet) 10 below top of ground.
  - (4) casing PVC 47'  
 (material) (depth)  
 If telescope see back.  
 (size)
  - (5) screen 5' 47'  
 (length) (depth to top)  
2 1/2 PVC  
 (size) (material)
  - (6) pump 1 7  
 (HP) (yield gpm)  
Elect  
 (type power)
  - (7) electric log NO  
 (yes or no)  
 (organization running log)
  - (8) how well bottom plugged Value

DRILLERS REMARKS:

NOV 5 1973

If well telescopes please sketch and show depths.

GROUND LEVEL

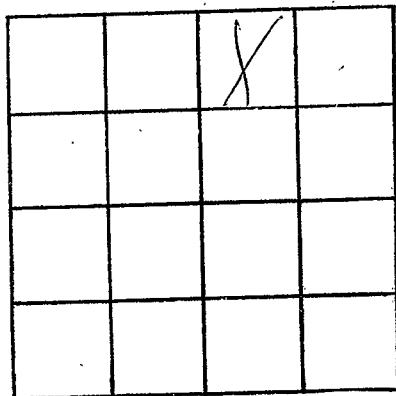

SECTION 30

Please indicate well location X.

ADDITIONAL INFORMATION

If more than one screen, show locations of each on sketch.