

Perry
 J41
 8-2-73

MISSISSIPPI
 BOARD OF WATER COMMISSIONERS
 416 North State Street
 Jackson, Mississippi 39201

WATER WELL DRILLERS LOG

August 2 1973 Cochran Drillers Perry
 date well completed firm name county well located

LANDOWNER:
 Doc. Deakles
 Rt. 1, Beaumont
 (mailing address)

WELL LOCATION:
 sec. 29 T 3 N R 9 E S W
 3 miles North of Beaumont
 (distance) (direction) (nearest town)

description of formations encountered	from	to
top soil	0	5
brown clay	2	11
gray clay	11	27
red clay	27	34
blue clay	34	89
gray clay	89	149
sand	149	168
blue clay	168	219
s. shale	219	352
sand	352	378
blue clay	378	470
sand	470	530

WELL PURPOSE: home
 (home, irrigation, municipal, industrial)

WELL COMPLETION DATA:

(1) diameter (inches) 2"

(2) total depth (feet) 530'

(3) static water level (feet) below top of ground. above

(4) casing PUC, 515'
 (material) (depth)
 (size) if telescope see back.

(5) screen 15', 515'
 (length) (depth to top)
 2" PUC
 (size) (material)

(6) pump — 30
 (HP) (yield gpm)
 (type power)

(7) electric log no
 (yes or no)
 (organization running log)


(8) how well bottom plugged valve

DRILLERS REMARKS:

NOV 5 1973

If well telescopes please sketch and show depths.

GROUND LEVEL

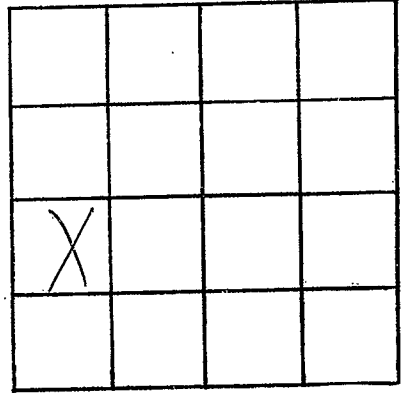

SECTION 29

Please indicate well location X.

ADDITIONAL INFORMATION

If more than one screen, show locations of each on sketch.