

PERRY
J-43
12-8-73

MISSISSIPPI
 BOARD OF WATER COMMISSIONERS
 416 North State Street
 Jackson, Mississippi 39201

73 WATER WELL DRILLERS LOG

12-8-73 date well completed **Small Drilling Co Perry** firm name **Perry** county well located

LANDOWNER: **Edman Jell**
Box 152
Beaman Miss
 (mailing address)

WELL LOCATION:
 sec. **4** T. **3** N. R. **9** E. S. **1** W.
1/4 miles (distance) **N** (direction) **Beaman** (nearest town)

WELL PURPOSE: **None**
 (home, irrigation, municipal, industrial)

WELL COMPLETION DATA:

(1) diameter (inches) **2"**

(2) total depth (feet) **505 ft**

(3) static water level (feet) **7' below top of ground**

(4) casing **Plastic, 490 ft** (material) (depth)
2" (size) if telescope see back.

(5) screen **15 ft, 505 ft** (length) (depth to top)
2" (size) **Plastic** (material)


(6) pump (HP) (yield gpm)
 (type power)

(7) electric log (yes or no)

(8) how well bottom plugged **None**

description of formations encountered	from	to
clay	0	9
sand	9	18
clay	18	30
clay	30	90
loamy clay	90	105
clay	105	255
shell	255	275
loamy clay	275	290
fine sand	290	305
clay	305	360
shaly g.c.	360	405
fine sand	405	468
hard sand	468	505


DRILLERS REMARKS:

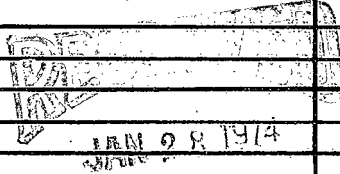

MISS. RD. OF WATER COMMISSIONERS

If well telescopes please
sketch and show depths.

GROUND LEVEL

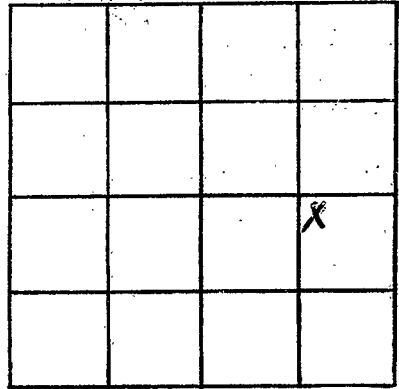

SECTION _____

Please indicate well location X.

ADDITIONAL INFORMATION

If more than one screen,
show locations of each on sketch.