

PERRY
J 44
2-7-74

MISSISSIPPI
 BOARD OF WATER COMMISSIONERS
 416 North State Street
 Jackson, Mississippi 39201

CODED

WATER WELL DRILLERS LOG

2-7-74 date well completed Small Drilling Inc firm name Perry county well located


LANDOWNER	Description of formations encountered	from	to
<u>R. F. D. #</u>	<u>Clay</u>	<u>0</u>	<u>18</u>
<u>Repton Miss.</u> (mailing address)	<u>Rock</u>	<u>18</u>	<u>22</u>
WELL LOCATION:	<u>Clay</u>	<u>22</u>	<u>120</u>
sec <u>4</u> T <u>N</u> R <u>9</u> E S W	<u>Shell</u>	<u>120</u>	<u>145</u>
<u>8</u> miles <u>NE</u> of <u>Sumner</u> (distance) (direction) (nearest town)	<u>Clay</u>	<u>145</u>	<u>175</u>
WELL PURPOSE: <u>church</u> (home, irrigation, municipal, industrial)	<u>Fine sand</u>	<u>175</u>	<u>180</u>
WELL COMPLETION DATA:	<u>Clay</u>	<u>180</u>	<u>205</u>
(1) diameter (inches) <u>2"</u>	<u>Creosote etc.</u>	<u>205</u>	<u>210</u>
(2) total depth (feet) <u>465 ft</u>	<u>Shell</u>	<u>210</u>	<u>285</u>
(3) static water level (feet) <u>16 ft</u> below top of ground.	<u>Fine sand</u>	<u>285</u>	<u>298</u>
(4) casing <u>Plastic</u> , <u>455 ft</u> (material) (depth)	<u>Clay</u>	<u>298</u>	<u>352</u>
<u>2"</u> if telescope see back. (size)	<u>Fine sand</u>	<u>352</u>	<u>360</u>
(5) screen <u>10 ft</u> , <u>465 ft</u> (length) (depth to top)	<u>Clay</u>	<u>360</u>	<u>420</u>
<u>2"</u> , <u>Plastic</u> (size) (material)	<u>Fine sand</u>	<u>420</u>	<u>432</u>
(6) pump <u>1</u> <u>900 RWHR</u> (HP) (yield gpm)	<u>Coarse sand</u>	<u>432</u>	<u>465</u>
<u>Foot</u> (type power)			
(7) electric log <input checked="" type="checkbox"/> (yes or no)			
(organization running log)			
(8) how well bottom plugged <u>None</u>			
DRILLERS REMARKS:			

MAR 1 9 1974

MISS. BD. OF WATER COMMISSIONERS

If well telescopes please sketch and show depths.

GROUND LEVEL

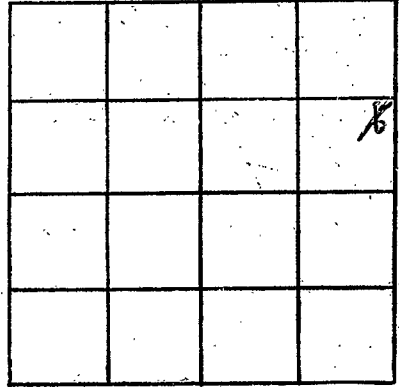

SECTION _____

Please indicate well location X.

ADDITIONAL INFORMATION

If more than one screen, show locations of each on sketch.