

Perry
 J 45
 3-22-74

MISSISSIPPI
 BOARD OF WATER COMMISSIONERS
 416 North State Street
 Jackson, Mississippi 39201

CODED

WATER WELL DRILLERS LOG

3-22-1974 date well completed
 J. J. Drilling & Service firm name
 Perry county well located


LANDOWNER: <u>Warren J. Jeffers</u>	description of formations encountered	from	to
<u>Ret. D. 4</u>	<u>Clay</u>	<u>0</u>	<u>23</u>
<u>Pickens miss.</u> (mailing address)	<u>Sandy clay</u>	<u>21</u>	<u>56</u>
WELL LOCATION: sec. <u>3</u> T. <u>3</u> N. R. <u>9</u> E. <u>6</u> miles <u>S</u> of <u>Pickens</u> (distance) (direction) (nearest town)	<u>Fine sand</u>	<u>56</u>	<u>78</u>
WELL PURPOSE: <u>Home</u> (home, irrigation, municipal, industrial)	<u>Coal sand</u>	<u>78</u>	<u>105</u>
WELL COMPLETION DATA: (1) diameter (inches) <u>2 1/4</u> (2) total depth (feet) <u>105 ft</u> (3) static water level (feet) <u>67 ft</u> below top of ground. (4) casing <u>Plastic, 500 ft.</u> (material) (depth) <u>2"</u> If telescope see back. (size) (5) screen <u>5 ft.</u> <u>105 ft.</u> (length) (depth to top) <u>2"</u> <u>Plastic</u> (size) (material) (6) pump <u>3/4</u> <u>450 GPM.</u> (HP) (yield gpm) <u>AC</u> (type power) (7) electric log <input checked="" type="checkbox"/> (yes or no) (organization running log) (8) how well bottom plugged <u>plastic</u>			
DRILLERS REMARKS:			

CODED

APR 24 1974

If well telescopes please sketch and show depths.

GROUND LEVEL

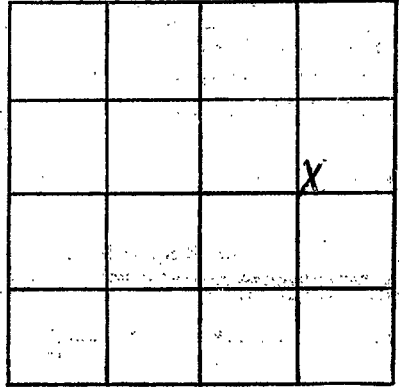

SECTION _____

Please indicate well location X.

ADDITIONAL INFORMATION

Multiple horizontal lines for writing additional information.

If more than one screen, show locations of each on sketch.