

Perry
J46
5-3-74

MISSISSIPPI
BOARD OF WATER COMMISSIONERS
416 North State Street
Jackson, Mississippi 39201

CODED

WATER WELL DRILLERS LOG

5-3 date well completed 1974 firm name *Summit Drilling Per Perry* County well located

LANDOWNER: *Miss Lake Ranch*
R.F.D. 4
Richter Miss
(mailing address)


WELL LOCATION:
sec. *4* T *3* N R *9* E
15 miles *S.E.* of *Richter*
(distance) (direction) (nearest town)

WELL PURPOSE: *Ranch*
(home, irrigation/municipal, industrial)

- WELL COMPLETION DATA:
- (1) diameter (inches) *2"*
 - (2) total depth (feet) *500 ft*
 - (3) static water level (feet) *19 ft* below top of ground.
 - (4) casing *plastic, 490 ft*
(material) (depth)
2" if telescope see back.
(size)
 - (5) screen *10 ft, 500 ft*
(length) (depth to top)
2", *plastic*
(size) (material)
 - (6) pump *1* *900 gpm*
(HP) (field gpm)
jet
(type power)
 - (7) electric log
(yes or no)
(organization running log)
 - (8) how well bottom plugged


description of formations encountered	from	to
<i>Clay</i>	<i>0</i>	<i>80</i>
<i>sandy clay</i>	<i>80</i>	<i>91</i>
<i>clay</i> CODED	<i>91</i>	<i>120</i>
<i>sandy clay</i>	<i>120</i>	<i>155</i>
<i>fine sand</i>	<i>155</i>	<i>170</i>
<i>hard sand</i>	<i>170</i>	<i>192</i>
<i>clay</i>	<i>192</i>	<i>235</i>
<i>fine sand</i>	<i>235</i>	<i>250</i>
<i>hard sand</i>	<i>250</i>	<i>260</i>
<i>clay</i>	<i>260</i>	<i>278</i>
<i>hard sand</i>	<i>278</i>	<i>310</i>
<i>clay</i>	<i>310</i>	<i>350</i>
<i>clay</i>	<i>350</i>	<i>385</i>
<i>fine sand</i>	<i>385</i>	<i>420</i>
<i>clay-sandy</i>	<i>420</i>	<i>440</i>
<i>hard sand</i>	<i>440</i>	<i>500</i>

DRILLERS REMARKS:

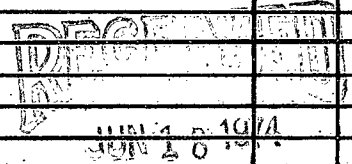

If well telescopes please sketch and show depths.

GROUND LEVEL

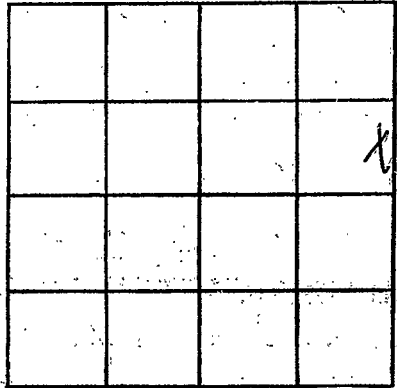

SECTION _____

Please indicate well location X.

ADDITIONAL INFORMATION

Multiple horizontal lines for additional information.

If more than one screen, show locations of each on sketch.