

Perry
 J 47
 7-29-74

MISSISSIPPI
 BOARD OF WATER COMMISSIONERS CODED
 416 North State Street
 Jackson, Mississippi 39201

WATER WELL DRILLERS LOG

7-29-74 date well completed
 74 General Drilling Co. firm name
 Perry county well located

LANDOWNER: Twinn Lake Park
 P.P.O.
 Richter miss.
 (mailing address)

WELL LOCATION:
 sec. 4 T. 3 N. R. 9 E.
 S. W.
 15 miles S.E. of Dickson
 (distance) (direction) (nearest town)

WELL PURPOSE: Rock
 (home, irrigation, municipal, industrial)

WELL COMPLETION DATA:
 (1) diameter (inches) 2"
 (2) total depth (feet) 440 ft
 (3) static water level (feet) below top of ground.
 (4) casing Aluminum, 430'
 (material) (depth)
2" If telescope see back.
 (size)
 (5) screen 10 ft, 440 ft
 (length) (depth to top)
2", Aluminum
 (size) (material)
 (6) pump 1, 900 gpm
 (HP) (yield gpm)
3/4
 (type power)
 (7) electric log ✓
 (yes or no)
✓
 (organization running log)
 (8) how well bottom plugged Valued

description of formations encountered	from	to
clay	0	12
fine sand	12	20
clay	20	174
coarse sand	174	179
clay	179	211
shell	211	220
fine sand	220	228
shell	228	240
clay	240	255
fine sand	255	260
clay	260	380
fine sand	380	420
sea shell sand	420	440


RECEIVED
 SEP 11 1974

DRILLERS REMARKS:

MISS. BD. OF WATER COMMISSIONERS

If well telescopes please sketch and show depths.

GROUND LEVEL

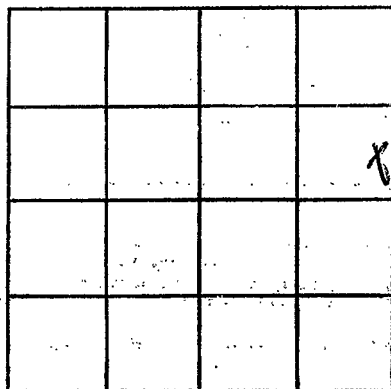

SECTION _____

Please indicate well location X.

ADDITIONAL INFORMATION

Lined area for additional information.

If more than one screen, show locations of each on sketch.