

Perry
J48
9/5/74

MISSISSIPPI
BOARD OF WATER COMMISSIONERS
416 North State Street
Jackson, Mississippi 39201

WATER WELL DRILLERS LOG CODED

Sept 5 1974 Cochran Drilling Perry
 date well completed firm name county well located

LANDOWNER:
Russel Pittman
Beaumont Miss.
(mailing address)

WELL LOCATION:
sec 29 T 3 (N) R 9 E
1 1/2 miles N of Beaumont
(distance) (direction) (nearest town)

WELL PURPOSE: home
(home, irrigation, municipal, industrial)

WELL COMPLETION DATA:

(1) diameter (inches) 2"

(2) total depth (feet) 530'

(3) static water level (feet) 20 below above top of ground

(4) casing PVC 515'
(material) (depth)
15' If telescope see back.
(size)

(5) screen 15' 515'
(length) (depth to top)
2" PVC
(size) (material)

(6) pump 1
(HP) (yield gpm)
(type power)

(7) electric log no
(yes or no)
(organization running log)

(8) how well bottom plugged Value


description of formations encountered	from	to
top soil	0	2
red clay	2	14
red sand	14	37
sand	37	58
blue clay	58	123
broken clay	123	172
white clay	172	184
blue clay	184	223
sand	223	241
blue clay	241	297
weathered clay	297	341
sand	341	351
blue clay	351	418
shale	418	442
blue clay	442	483
sand	483	530

MISSISSIPPI
BOARD OF WATER COMMISSIONERS
NOV 12 1974

DRILLERS REMARKS:

If well telescopes please sketch and show depths.

GROUND LEVEL

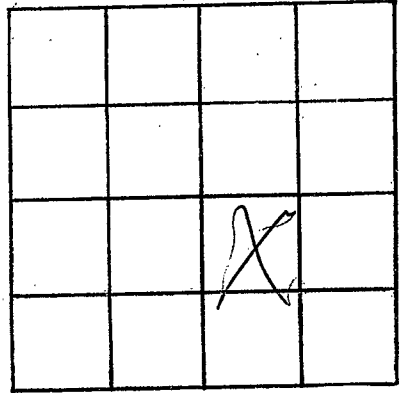

SECTION 29

Please indicate well location X.

ADDITIONAL INFORMATION

If more than one screen, show locations of each on sketch.