

Perry

J49

9-7-74

MISSISSIPPI  
 BOARD OF WATER COMMISSIONERS  
 416 North State Street  
 Jackson, Mississippi 39201

CODED

WATER WELL DRILLERS LOG

Sept 7 1974  
date well completed

74 Cochran Drilling  
firm name

Perry  
county well located

LANDOWNER:

Jessley Lott  
Beaumont, Miss  
(mailing address)

description of formations encountered

from to

sandy soil	0	5
red clay	5	19
red sand	19	24
sand & gravel	24	78
gray clay	78	135
brown clay	135	172
blue clay	172	285
shale	285	297
blue clay	297	315
sand	315	337
blue clay	337	375
CODED	375	384
blue clay	384	420
sand	420	480

WELL LOCATION:

sec. 35 T 3 N R 9 E  
4 miles N.E. of Beaumont  
(distance) (direction) (nearest town)

WELL PURPOSE:

home  
(home, irrigation, municipal, industrial)

WELL COMPLETION DATA:


- (1) diameter (inches) 9"
- (2) total depth (feet) 480'
- (3) static water level (feet) 21' below top of ground.
- (4) casing P.V.C. 465' (material) (depth)  
(size) If telescope see back.
- (5) screen 15' 465' (length) (depth to top)  
2" P.V.C. (size) (material)
- (6) pump (HP) (yield gpm)  
(type power)
- (7) electric log No (yes or no)  
(organization running log)
- (8) how well bottom plugged Valve

DRILLERS REMARKS:

DRILLERS  
NOV 12 1974

If well telescopes please sketch and show depths.

GROUND LEVEL

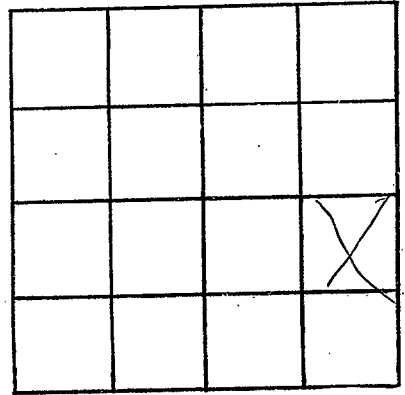

SECTION 35

Please indicate well location X.

ADDITIONAL INFORMATION

If more than one screen, show locations of each on sketch.