

Perry
 J 50
 9/20/74

MISSISSIPPI
 BOARD OF WATER COMMISSIONERS
 416 North State Street
 Jackson, Mississippi 39201

CODED

WATER WELL DRILLERS LOG

Sept 20 1974 Carhon Drilling Perry
 date well completed firm name county well located

LANDOWNER:
Wayne Watford
Beaumont Miss.
 (mailing address)

description of formations encountered	from	to
TOP soil	0	2
red clay	2	14
red sand	14	32
sand	32	58
blue clay	58	123
brown clay	123	172
white clay	172	184
blue clay	184	223
sand	223	241
bee clay	241	297
white clay	297	341
yellow clay	341	351
blue clay	351	418
shale	418	442
blue clay	442	483
sand	483	535

WELL LOCATION:
 sec. 29 T. 3 N. R. 9 E
1 1/2 miles N of Beaumont
 (distance) (direction) (nearest town)

WELL PURPOSE: none
 (home, irrigation, municipal, industrial)


WELL COMPLETION DATA:
 (1) diameter (inches) 2"
 (2) total depth (feet) 535'
 (3) static water level (feet) 21 below top of ground. above
 (4) casing PLC 520'
 (material) (depth)
 (size) if telescope see back.
 (5) screen 15' 520'
 (length) (depth to top)
2" PLC
 (size) (material)
 (6) pump _____ (HP) _____ (yield gpm)
 (type power)
 (7) electric log no
 (yes or no)
 (organization running log)
 (8) how well bottom plugged value

DRILLERS REMARKS:

PROCESSED
 NOV 12 1974

If well telescopes please sketch and show depths.

GROUND LEVEL

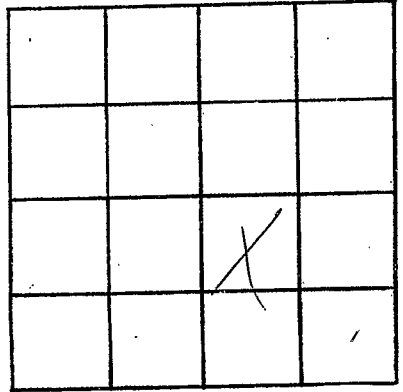

SECTION 29

Please indicate well location X.

ADDITIONAL INFORMATION

If more than one screen,
show locations of each on sketch.