

Perry
 J51
 9/10/74

MISSISSIPPI
 BOARD OF WATER COMMISSIONERS
 416 North State Street
 Jackson, Mississippi 39201 **CODED**

WATER WELL DRILLERS LOG

Sept 10 1974 Cochran Drilling Perry
 date well completed firm name county well located

LANDOWNER: ~~Sept 10~~
 TA De Vore
 Beaumont Min
 (mailing address)

WELL LOCATION:
 sec. 20 T 3 (N) R 9 E (W)
 2 1/2 miles N of Beaumont
 (distance) (direction) (nearest town)

WELL PURPOSE: home
 (home, irrigation, municipal, industrial)

- WELL COMPLETION DATA:
- (1) diameter (inches) 2"
 - (2) total depth (feet) 535'
 - (3) static water level (feet) 19 below top of ground. above
 - (4) casing PVC, 520'
 (material) (depth)
 If telescope see back.
 (size)
 - (5) screen 15', 520'
 (length) (depth to top)
2", PVC
 (size) (material)
 - (6) pump _____
 (HP) (yield gpm)
 (type power)
 - (7) electric log no
 (yes or no)
 (organization running log)
 - (8) how well bottom plugged valve

description of formations encountered	from	to
Tap soil	0	3
red sand	3	12
red clay	12	33
brown clay	33	42
sand	42	51
blue clay	51	197
white clay	197	228
sand	228	245
blue clay	245	390
shale	390	418
brown clay	418	427
blue clay	427	479
sand	479	535


CODED

DRILLERS REMARKS:

NOV 10 1974

If well telescopes please sketch and show depths.

GROUND LEVEL

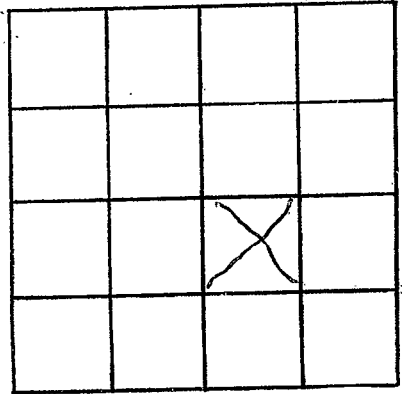

SECTION 20

Please indicate well location X.

ADDITIONAL INFORMATION

If more than one screen, show locations of each on sketch.