

Perry  
 J54  
 9-19-74

MISSISSIPPI  
 BOARD OF WATER COMMISSIONERS  
 416 North State Street  
 Jackson, Mississippi 39201

CODED

WATER WELL DRILLERS LOG

Sept 14 1974 Cochran Drilling Perry  
 date well completed firm name county well located

LANDOWNER:  
John Garden  
Beaumont Miss  
 (mailing address)

description of formations encountered	from	to
Top soil	0	1 1/2
red sand	1 1/2	10
red	10	38
sand & gravel	38	47
brown	47	56
white	56	78
blue clay	78	184
sand	184	211
brown clay	211	246
blue clay	246	381
shale	381	403
blue clay	403	484
sand	484	530

WELL LOCATION:  
 sec. 20 T 3 S R 9 E  
2 1/2 miles N of Beaumont  
 (distance) (direction) (nearest town)


WELL PURPOSE: none  
 (home, irrigation, municipal, industrial)

WELL COMPLETION DATA:

- (1) diameter (inches) 2"
- (2) total depth (feet) 530'
- (3) static water level (feet) 22 below top of ground above
- (4) casing PVC 515'  
 (material) (depth)  
 (size) If telescope see back.
- (5) screen 15' 515'  
 (length) (depth to top)  
2" PVC  
 (size) (material)
- (6) pump \_\_\_\_\_  
 (HP) (yield gpm)  
 (type power)
- (7) electric log no  
 (yes or no)  
 (organization running log)
- (8) how well bottom plugged valve

CODED

DRILLERS REMARKS:

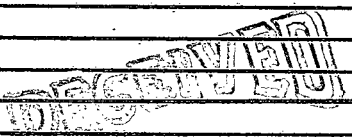


NOV 16 1974

MISS. BD. OF WATER COMMISSIONERS

If well telescopes please sketch and show depths.

GROUND LEVEL

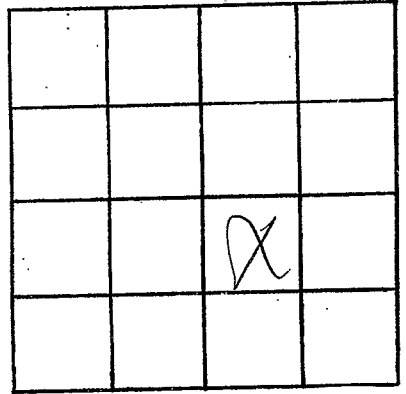

SECTION 20

Please indicate well location X.

ADDITIONAL INFORMATION

If more than one screen, show locations of each on sketch.