

Perry
 J 56
 3-14-75

MISSISSIPPI
 BOARD OF WATER COMMISSIONERS
 416 North State Street
 Jackson, Mississippi 39201

CODED

WATER WELL DRILLERS LOG

3/14/75 1975 Cochran Drilling Service Perry
 date well completed firm name county well located

LANDOWNER:
 Peter Breland
 Rt 8 Beaumont
 (mailing address)

description of formations encountered	from	to
Top soil	0	3
red clay	3	7
brown clay	7	14
sand	14	23
white clay	23	37
blue clay	37	49
sand & gravel	49	100

WELL LOCATION:
 sec. 17 T 30 N R 9 E
 S W
 5 miles N of Beaumont
 (distance) (direction) (nearest town)

WELL PURPOSE: home
 (home, irrigation, municipal, industrial)

- WELL COMPLETION DATA:
- (1) diameter (inches) 4"
 - (2) total depth (feet) 100'
 - (3) static water level (feet) 40' ^{below} above top of ground.
 - (4) casing PVC, 90'
 (material), (depth)
 (size) if telescope see back.
 - (5) screen 10', 90'
 (length), (depth to top)
 4" PVC
 (size), (material)
 - (6) pump 1 1/2 horsepower
 (HP), (yield gpm)
 Elect.
 (type power)
 - (7) electric log no
 (yes or no)
 (organization running log)
 - (8) how well bottom plugged Valve

CODED


RECEIVED
 APR 10 1975

MISS. BD. OF WATER COMMISSIONERS

DRILLERS REMARKS:

If well telescopes please sketch and show depths.

GROUND LEVEL

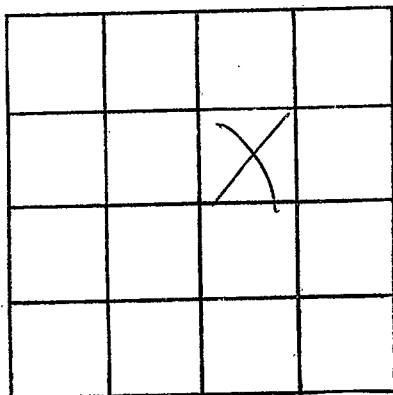

SECTION 17

Please indicate well location X.

ADDITIONAL INFORMATION

If more than one screen,
show locations of each on sketch.