

**MISSISSIPPI  
BOARD OF WATER COMMISSIONERS**  
416 North State Street  
Jackson, Mississippi 39201

**CODED**

**WATER WELL DRILLERS LOG**

Perry  
J 581  
7-10-75

July 10 1975 Cochran Drilling Service Perry  
date well completed firm name county well located

LANDOWNER: W. T. Freeman

Route 2

Beaumont  
(mailing address)

WELL LOCATION:

sec 20 T 3N R 9 13a  
S W  
3 miles NE of Beaumont  
(distance) (direction) (nearest town)

WELL PURPOSE: Home  
(home, irrigation, municipal, industrial)

WELL COMPLETION DATA:

- (1) diameter (inches) 2"
- (2) total depth (feet) 525'
- (3) static water level (feet) below  
top of ground.
- (4) casing PVC, 510'  
(material) (depth)  
         If telescope see back.  
(size)
- (5) screen 15', 510'  
(length) (depth to top)  
2", PVC  
(size) (material)
- (6) pump         , 50  
(HP) (yield gpm)  
          
(type power)
- (7) electric log no  
(yes or no)  
          
(organization running log)
- (8) how well bottom plugged valve

description of formations encountered

from

to

TOP soil	0	2
red clay	2	5
red sand	5	11
sand & gravel	11	27
Brown clay	27	39
gray clay	39	74
Blue clay	74	139
sand	139	144
Blue clay	144	198
shale	198	214
Blue clay	214	376
Sandy shale	376	420
Blue clay	420	485
sand	485	525

**CODED**


DRILLERS REMARKS:

SEP 2 1975

MISSISSIPPI BOARD OF WATER COMMISSIONERS

If well telescopes please sketch and show depths.

GROUND LEVEL

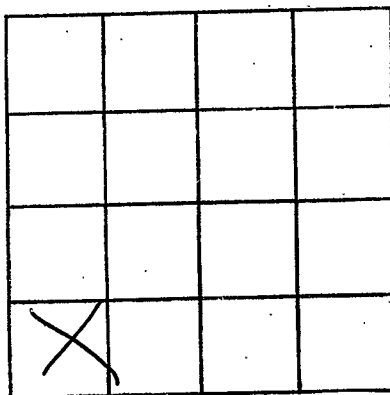

SECTION 20

Please indicate well location X.

ADDITIONAL INFORMATION

If more than one screen, show locations of each on sketch.