

Perry  
 J 59  
 7-24-75

MISSISSIPPI  
 BOARD OF WATER COMMISSIONERS  
 416 North State Street  
 Jackson, Mississippi 39201

CODED

WATER WELL DRILLERS LOG

July 24 1975 Cochran Drilling Service PERRY  
 date well completed firm name county well located

LANDOWNER: Dorise M. Dorah

description of formations encountered

Rt. 2

from to

Beaumont  
 (mailing address)

Top soil 0 3  
Red clay 3 8  
White clay 8 11  
Brown clay 11 16  
Red sand 16 23  
sand + gravel 23 50

WELL LOCATION:  
 sec. 20-T-3(N) R. 9 13<sup>th</sup> S. W  
2 miles N of Beaumont  
 (distance) (direction) (nearest town)

WELL PURPOSE: None  
 (home, irrigation, municipal, industrial)

WELL COMPLETION DATA:

- (1) diameter (inches) 2"
- (2) total depth (feet) 50'
- (3) static water level (feet) 14' below top of ground.
- (4) casing PVC, 45'  
 (material) (depth)  
 If telescope see back.  
 (size)
- (5) screen 5', 45'  
 (length) (depth to top)  
2", PVC  
 (size) (material)
- (6) pump 1 7  
 (HP) (yield gpm)  
Elec  
 (type power)
- (7) electric log no  
 (yes or no)  
 (organization running log)
- (8) how well bottom plugged valve

CODED


RECEIVED  
 SEP - 2 1975

DRILLERS REMARKS:

MISS. BD. OF WATER COMMISSIONERS

If well telescopes please sketch and show depths.

GROUND LEVEL

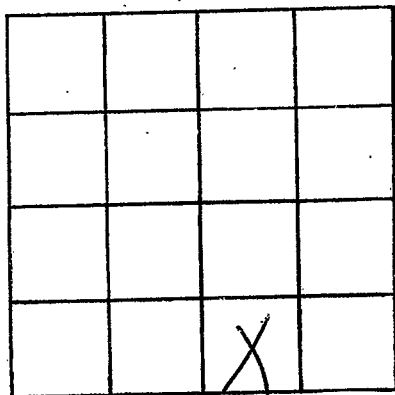

SECTION 20

Please indicate well location X.

ADDITIONAL INFORMATION

If more than one screen, show locations of each on sketch.