

Perry
 J61
 4-24-79

MISSISSIPPI
 BOARD OF WATER COMMISSIONERS
 416 North State Street
 Jackson, Mississippi 39201

CODED

WATER WELL DRILLERS LOG

4-24-1979 date well completed
 79 Cochran Drilling Perry firm name
 county well located

LANDOWNER:
 Shelby Byrd
 Beaumont Miss.
 (mailing address)

description of formations encountered	from	to
yellow clay	0	5
white clay	5	15
Coarse Sand & gravel	15	40
Green clay	40	140
Blue clay	140	245
Sand	245	260
Blue clay	260	280
Sand	280	305
Blue sand	305	499
Sand & gravel	499	570

WELL LOCATION:
 sec. 20 T 3 N R 9 E
 2 miles North of Beaumont
 (distance) (direction) (nearest town)

WELL PURPOSE: house
 (home, irrigation, municipal, industrial)

WELL COMPLETION DATA:

(1) diameter (inches) 2"

(2) total depth (feet) 570'

(3) static water level (feet) 20' below top of ground.

(4) casing PVC, 550'
 (material) (depth)

if telescope see back.
 (size)

(5) screen 20', 550'
 (length) (depth to top)

2" PVC
 (size) (material)

(6) pump None 38
 (HP) (yield gpm)

None
 (type power)

(7) electric log no
 (yes or no)

(organization running log)

(8) how well bottom plugged V drive

CODED

Miss. Board of Water Comm.


MAY 25 1979

EIVED

DRILLERS REMARKS:

If well telescopes please sketch and show depths.

GROUND LEVEL

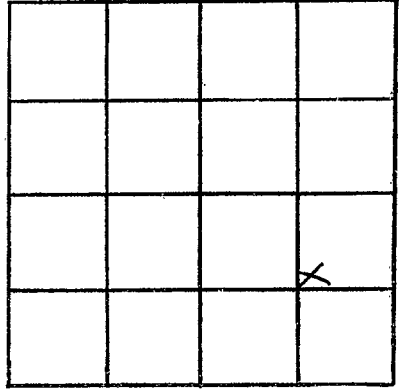

SECTION 20

Please indicate well location X.

ADDITIONAL INFORMATION

On Hwy 15
2 miles North
of Beaumont
across Hwy
from Eben Jordan

If more than one screen,
show locations of each on sketch.