

PERRY

J-62  
7-3-80

MISSISSIPPI  
BOARD OF WATER COMMISSIONERS  
416 North State Street  
Jackson, Mississippi 39201

CODED

WATER WELL DRILLERS LOG

July 3 1980 Cochran Drilling Service Perry  
date well completed firm name county well located

LANDOWNER:	description of formations encountered	from	to
description of formations encountered			
Luther Parker	Top soil	0	3
Rt 1 Beaumont (mailing address)	red clay	3	9
	red silt	9	13
	white clay	13	16
	sand	16	28
	blue clay	28	84
	gray clay	84	126
	shale	126	172
	blue clay	172	280
	sand	280	315
	blue clay	315	445
	shale	445	463
	white clay	463	491
	sand	491	560

CODED

LANDOWNER:

WELL LOCATION:

sec. 36 T 3 N R 9 E  
6 miles N.E. of Beaumont  
(distance) (direction) (nearest town)

WELL PURPOSE: home  
(home, irrigation, municipal, industrial)

WELL COMPLETION DATA:

- (1) diameter (inches) 2"
- (2) total depth (feet) 560'
- (3) static water level (feet) below/above top of ground
- (4) casing PVC 550'  
(material) (depth)
- (5) screen 10' 550'  
(length) (depth to top)
- 2" PVC  
(size) (material)
- (6) pump - 40 gal  
(HP) (yield gpm)
- (7) electric log (yes or no)
- (8) how well bottom plugged solve

DEPT. OF NATURAL RESOURCES  
BUREAU OF LAND & WATER RESOURCES


JUL 22 1980

RECEIVED

DRILLERS REMARKS:

If well telescopes please sketch and show depths.

GROUND LEVEL

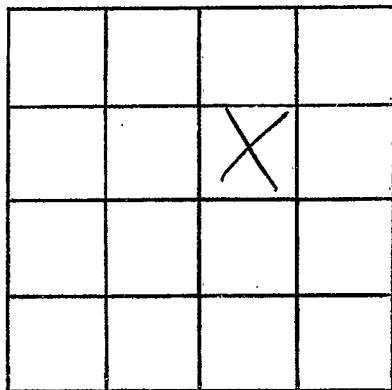

SECTION 36

Please indicate well location X.

ADDITIONAL INFORMATION

If more than one screen,  
show locations of each on sketch.