

PERDU

J-6.3
7-10-80

MISSISSIPPI
BOARD OF WATER COMMISSIONERS
416 North State Street
Jackson, Mississippi 39201

CODED

WATER WELL DRILLERS LOG

July 10 1980 Cochran Drilling Service Perry
date well completed firm name county well located

LANDOWNER:
Bill Lott
Rt 1, Beaumont
(mailing address)

description of fomations encountered	from	to
Top soil	0	2
red clay	2	14
red sand	14	32
sand	32	38
blue clay	58	123
brown clay	123	172
white clay	172	184
blue clay	184	223
sand	223	247
blue clay	247	297
gray clay	297	341
sand	341	351
blue clay	351	418
shale	418	442
blue clay	442	483
sand	483	545

WELL LOCATION:
sec. 29 T 3 N R 9 E
2 miles N of Beaumont
(distance) (direction) (nearest town)

WELL PURPOSE: home
(home, irrigation, municipal, industrial)

WELL COMPLETION DATA:

(1) diameter (inches) 2"

(2) total depth (feet) 545'

(3) static water level (feet) _____
top of ground. (below/above)

(4) casing PVC, 530'
(material) (depth)

_____ if telescope see back.
(size)

(5) screen 15' 530'
(length) (depth to top)

2" PVC
(size) (material)

(6) pump - 38 gal.
(HP) (yield gpm)

_____ (type power)

(7) electric log no
(yes or no)

_____ (organization running log)

(8) how well bottom plugged solve

DEPT. OF NATURAL RESOURCES
BUREAU OF LAND & WATER RESOURCES


JUL 22 1980

RECEIVED

DRILLERS REMARKS:

If well telescopes please sketch and show depths.

GROUND LEVEL

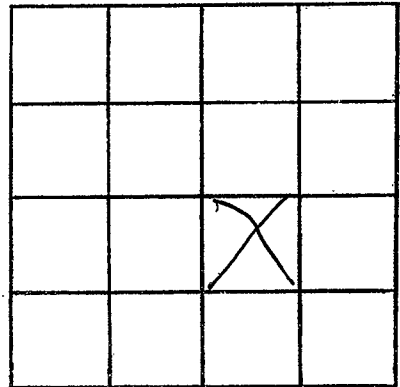

SECTION 29

Please indicate well location X.

ADDITIONAL INFORMATION

If more than one screen,
show locations of each on sketch.