

MISSISSIPPI DEPARTMENT OF NATURAL RESOURCES

Bureau of Land and Water Resources

Southport Mall

P.O. Box 10631

CODED

Jackson, Mississippi 39209

WATER WELL DRILLERS LOG

Perry
J64
6/4/82

June 4 1982 Coeheran Bro. Drilling Perry
date well completed firm name county well located

LANDOWNER:
George Tryee
Rt 1 Beaumont
(mailing address)

description of formations encountered	from	to
TOP Soil	0	2
Red clay	2	6
Red sand	6	12
Sand + gravel	12	38
gray clay	38	75
Blue clay	75	210
sand	210	230
Blue clay	230	380
Shale	380	410
Blue clay	410	480
Sand	480	545

WELL LOCATION:
sec. 25 T. 30 S. R. 9 E. W. 1
8 miles NE of Beaumont
(distance) (direction) (nearest town)

WELL PURPOSE: None
(home, irrigation, municipal, industrial)

WELL COMPLETION DATA:

(1) diameter (inches) 2"

(2) total depth (feet) 545'

(3) static water level (feet) below top of ground

(4) casing PVC, 535' (material) (depth)

(5) screen 10' 535' (length) (depth to top)
2" PVC (size) (material)

(6) pump 30 (HP) (yield gpm)

(7) electric log (yes or no)

(8) how well bottom plugged valve

CODED

DEPT. OF NATURAL RESOURCES
BUREAU OF LAND & WATER RESOURCES


OCT - 4 1982

RECEIVED

DRILLERS REMARKS:

If well telescopes please sketch and show depths.

GROUND LEVEL

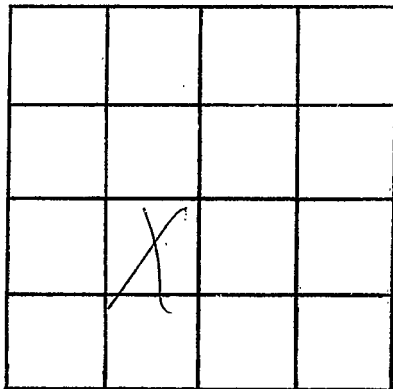

SECTION 25

Please indicate well location X.

ADDITIONAL INFORMATION

If more than one screen,
show locations of each on sketch.