

0018

MISSISSIPPI DEPARTMENT OF NATURAL RESOURCES

Bureau of Land and Water Resources

Southport Mall

P.O. Box 10631

CODED

Jackson, Mississippi 39209

WATER WELL DRILLERS LOG *FERRY*

<i>FERRY</i>
<i>J 66</i>
<i>5/24/83</i>

*5-24-83* 19 *FRYFOGIE WATER WELL* *GEORGE*  
 date well completed firm name county well located

LANDOWNER: *J.C. Jordan*  
*Rt. 1, BOX 250*  
*LUCEDALE, MS.*  
 (mailing address)

WELL LOCATION:  
 sec. *20* T *3* N R *9* E  
*9* miles *south* of *Barnot*  
 (distance) (direction) (nearest town)  
*By 15*

WELL PURPOSE:  
 (home, irrigation, municipal, industrial)

WELL COMPLETION DATA:

- (1) diameter (inches) *2 1/2*
- (2) total depth (feet) *505*
- (3) static water level (feet) *30*? below above top of ground.
- (4) casing *pvc*, *482*  
 (material), (depth)  
*no* if telescope see back.  
 (size)
- (5) screen *20*, *482*  
 (length), (depth to top)  
*2 1/2*, *pvc*  
 (size), (material)
- (6) pump *none*, *50-60*  
 (HP), (yield gpm)  
*none*  
 (type power)
- (7) electric log *no*  
 (yes of no)  
 (organization running log)
- (8) how well bottom plugged *pvc*  
*Ballch...*

description of formations encountered	from	to
<i>top soil</i>	<i>0</i>	<i>5</i>
<i>Sand</i>	<i>5</i>	<i>10</i>
<i>Clay</i>	<i>10</i>	<i>20</i>
<i>Sand</i>	<i>20</i>	<i>30</i>
<i>Clay</i>	<i>30</i>	<i>40</i>
<i>Sand</i>	<i>40</i>	<i>60</i>
<i>Sand</i>	<i>60</i>	<i>120</i>
<i>Clay Blue</i>	<i>120</i>	<i>140</i>
<i>Clay</i>	<i>140</i>	<i>200</i>
<i>Sand, Fine</i>	<i>250</i>	<i>265</i>
<i>Sand, Silt, Clay</i>	<i>260</i>	<i>350</i>
<i>Clay</i>	<i>350</i>	<i>480</i>
<i>good sand</i>	<i>480</i>	<i>505</i>

CODED

DEPT. OF NATURAL RESOURCES  
 BUREAU OF LAND & WATER RESOURCES


JUN 30 1983

RECEIVED

DRILLERS REMARKS:

If well telescopes please sketch and show depths.

GROUND LEVEL

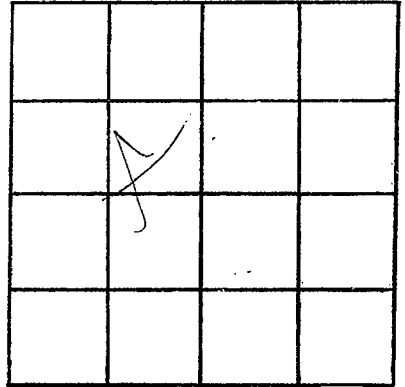

SECTION

20

Please indicate well location X.

ADDITIONAL INFORMATION

If more than one screen,  
show locations of each on sketch.