

MISSISSIPPI DEPARTMENT OF NATURAL RESOURCES

Bureau of Land and Water Resources

Southport Mall

P.O. Box 10631

Jackson, Mississippi 39209

WATER WELL DRILLERS LOG

CODED

Perry
567

12-8-85
date well completed

Tom Griffith Well Service
firm name

Perry
county well located

LANDOWNER: David New Drk Co.

P.O. Box 1487

Natchez, Ms 39120
(mailing address)

WELL LOCATION:

sec. 30 T 3 N R 9 E
S O
2 miles N of Beaumont, Ms
(distance) (direction) (nearest town)

WELL PURPOSE: Oil Location
(home, irrigation, municipal, industrial)

WELL COMPLETION DATA:

- (1) diameter (inches) 3"
- (2) total depth (feet) 820'
- (3) static water level (feet) 100' below top of ground.
- (4) casing PVC 480 (material), (depth)
- 1 1/4 (size) if telescope see back.
- (5) screen 40 (length), 480 (depth to top)
- 3" PVC (size), (material)
- (6) pump Air 100 (HP), (yield gpm)
- Air 1.5 (type power)
- (7) electric log No (yes or no)
- NA (organization running log)
- (8) how well bottom plugged BWV

description of formations encountered

from

to

Red Sand	0	40
Sand + Red Gravel	40	165
CLAY	165	185
FINE SAND	185	195
CLAY	195	220
SAND	220	280
CLAY	280	540
SAND	440	620

R.W. TYSON PRODUCING CO.

#2 VICTOR T MUNNET AL 30-1

798' S & 950' W OF NE CORNER

OK


REGISTERED
MAY 14 1985

Department of Natural Resources
Bureau of Land & Water Resources
CODED

DRILLERS REMARKS:

If well telescopes please sketch and show depths.

GROUND LEVEL

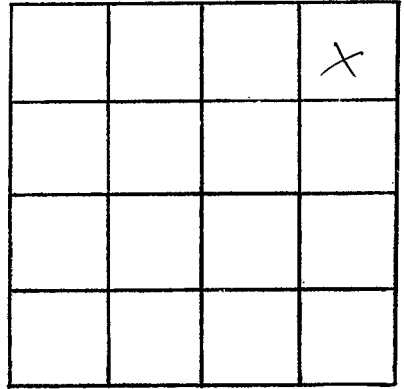

SECTION _____

Please indicate well location X.

ADDITIONAL INFORMATION

If more than one screen,
show locations of each on sketch.