

MISSISSIPPI DEPARTMENT OF NATURAL RESOURCES

Bureau of Land and Water Resources

Southport Mall

P.O. Box 10631


Jackson, Mississippi 39209

WATER WELL DRILLERS LOG

Perry
568

CODED


12-9-85 19 Tom Griffith Well Service Perry, Ms
date well completed firm name county well located

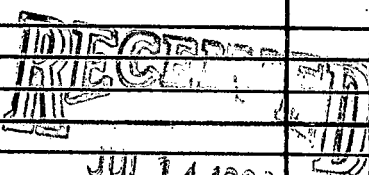LANDOWNER:	description of formations encountered	from	to
<u>David New Drly Co</u>	<u>SAND + Pea Gravel</u>	<u>0</u>	<u>90</u>
<u>P.O. Box 1487</u>	<u>CLAY</u>	<u>90</u>	<u>325</u>
<u>Natchez, Ms 39120</u> (mailing address)	<u>Sand</u>	<u>325</u>	<u>540</u>
WELL LOCATION: sec. <u>19</u> T. <u>4</u> S. R. <u>9</u> E. <u>W</u>			
<u>2</u> miles (distance) <u>N</u> (direction) of <u>Beaumont, Ms</u> (nearest town)	R. W. TYSON PRODUCING CO.		
WELL PURPOSE: <u>Oil Location</u> (home, irrigation, municipal, industrial)	#2 VICTOR F. MUNN ET AL 30-1		
WELL COMPLETION DATA:	<u>798'S ± 950 WAF NE/COR ?</u>		
(1) diameter (inches) <u>3"</u>	<u>BM Jenkins #9</u>		
(2) total depth (feet) <u>440'</u>	<u>2310' N ± 2040' W</u>		
(3) static water level (feet) <u>100'</u> <u>below</u> above top of ground.	<u>of SE corner</u>		
(4) casing <u>PVC</u> <u>400'</u> (material) (depth)	CODED		
<u>N/A</u> if telescope see back. (size)			
(5) screen <u>40</u> <u>400'</u> (length) (depth to top)	<u>JUL 14 1988</u>		
<u>3"</u> <u>PVC</u> (size) (material)	<u>Department of</u>		
(6) pump <u>Air</u> <u>100</u> (HP) (yield gpm)	<u>Bureau of Land and Water Resources</u>		
<u>Diesel</u> (type power)			
(7) electric log <u>No</u> (yes or no)			
<u>NA</u> (organization running log)			
(8) how well bottom plugged <u>BWV</u>			

DRILLERS REMARKS:

If well telescopes please sketch and show depths.

GROUND LEVEL

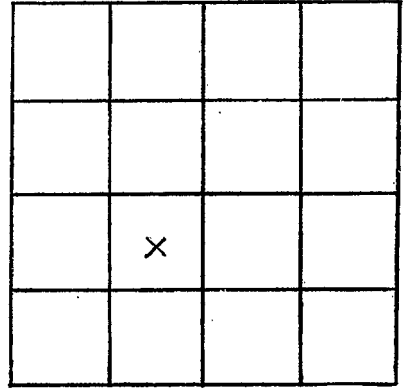

SECTION _____

Please indicate well location X.

ADDITIONAL INFORMATION

If more than one screen,
show locations of each on sketch.