

MISSISSIPPI DEPARTMENT OF ENVIRONMENTAL QUALITY

Office of Land and Water Resources

P. O. Box 10631
Jackson, MS 39289-0631
WATER WELL DRILLERS LOG

COUNTY WELL LOCATED <i>Parry</i>	
WELL NUMBER <i>J 75</i>	CODED
DATE WELL COMPLETED <i>12-25-95</i>	

PERMIT NUMBER <i>0408</i>
NAME OF DRILLING FIRM <i>Supple Well Serv.</i> <i>194 Depot Rd</i> <i>Sumner MS 39452</i>

NAME & MAILING ADDRESS OF LANDOWNER <i>G.W. Gilmore</i> <i>134 Kitchell Rd</i> <i>Beaumont MS 39423</i>			
WELL LOCATION <i>1 1/4</i>	SEC <i>18</i>	TOWNSHIP <i>T3 S</i>	RANGE <i>R9 E</i>
DISTANCE <i>4</i> Miles	DIRECTION <i>North</i>	NEAREST TOWN <i>Beaumont MS</i>	
OTHER LANDMARK <i>Close to Lake Parry</i>			
WELL PURPOSE: <input type="checkbox"/> Home, <input type="checkbox"/> Irrigation, <input type="checkbox"/> Municipal, <input type="checkbox"/> Industrial, <input type="checkbox"/> Fish Pond, etc.			

PUMP DATA			
PUMP TYPE (Circle One): Submersible, Turbine, <input checked="" type="radio"/> Jet, Flowing Well, Other (Describe) _____			
POWER TYPE (Circle One): <input checked="" type="radio"/> Electric, Tractor, Diesel, Gasoline, Butane, Other (Describe) _____ H/P _____			
Pump Capacity (GPM) <i>10</i>	No. of Stages <i>2</i>	Setting Depth <i>10'</i>	FT.
PUMP TEST			
Well yielded <i>15</i> GPM with a drawdown of <i>0</i> ft. after <i>1 1/2</i> hours of pumping			

WELL DATA		
Well Depth <i>473'</i>	Casing Diameter (In.) <i>2"</i>	Casing Length (Ft.) <i>463'</i>
Type of Casing <i>PVC</i>	Hole Depth <i>473</i>	Depth to Static Water Level <i>Overflow</i>
TYPE OF COMPLETION: (Circle One or More): Gravel Packed, Underreamed, Telescoped, Natural Development, Open Hole, Other (Describe) <i>air lift</i>		
WELL GROUTED TO A DEPTH OF <i>20</i> FEET Type Grout (circle one): Cement, Bentonite, or Mix		

LOG DATA	
TYPE OF LOG RUN (Circle One): Electric, Gamma Ray, Density, Sonic, Neutron, Other (Describe) _____	
Name of Organization Running Log	

SCREEN DATA		
Diameter - Inches <i>10'</i>	Length - Feet <i>2"</i>	Slot Size - Inches <i>#8</i>
Screen Type <i>Wrapped PVC</i>	Depth to Bottom - Feet <i>473</i>	


GEOLOGIC DATA (Office Use Only)			
Surface Elev.	Geologic Unit	Unit Thickness	Depth to Top
Subs. SWL	Date	Analysis	Aquifer Test
Driller's Remarks			
Top of Lap Pipe or Reduction in Casing			

DESCRIPTION OF FORMATIONS ENCOUNTERED	FROM	TO	FORMATION
<i>Top Soil</i>	<i>0</i>	<i>2</i>	<div style="border: 2px solid black; padding: 5px; display: inline-block;"> RECEIVED FEB 21 1996 Dept. of Environmental Quality Office of Land & Water Resources </div>
<i>Sand</i>	<i>5</i>	<i>20</i>	
<i>Clay</i>	<i>20</i>	<i>40</i>	
<i>11"</i>	<i>40</i>	<i>80</i>	
<i>11"</i>	<i>80</i>	<i>100</i>	
<i>Blue Clay</i>	<i>100</i>	<i>200</i>	
<i>Blue Clay</i>	<i>200</i>	<i>300</i>	
<i>Shale Sand & clay</i>	<i>300</i>	<i>400</i>	
<i>Sand</i>	<i>400</i>	<i>473</i>	

IF MORE SPACE IS NEEDED, USE BACK

If well telescopes please sketch and show depths.

GROUND LEVEL

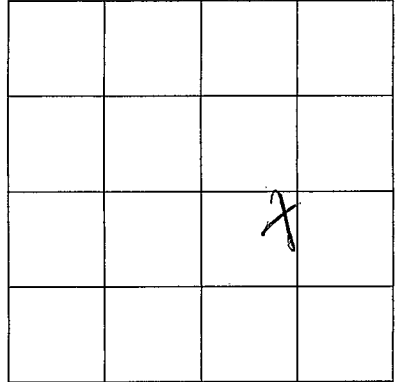

SECTION 18

Please indicate well location X.

ADDITIONAL INFORMATION

If more than one screen,
show location of each on sketch.