G	tate Well Report			
County: perry	Part 1	For Office Use Only:		
Mississippi D	Department of Environmental Quality	Aquifer:		
Permit #: Office	of Land and Water Resources	Well #: J- 83		
Driller: H. Willbaung	P.O. Box 10631 ackson, MS 39289-0631	and the second sec		
Date drilling completed: 0212-8/09	(601)961-5210	L. S. Elevation:		
· <i>i</i>	(601)354-6938 (fax)	E-log #:		
State Law requires that this report be prepare 30 days of completion of drilling of the well.	ed by the driller in detail and filed w	with the Department within		
Well Owner Information	Well	Location		
Owner Name James Mone	Latitude: 31 ° 12 , 15	" Longitude: 88 . 53, 31 "		
Mailing Address: P. O. Box 412 3942	3 Method of Lat/Long (circle or	ne): Conventional Survey,		
75 Arlington Loop	USGS quad, Hand-held	USGS quad, Hand-held GPS, Survey-grade GPS		
Beaumont Ms. 394.	23 SW 1/4 SW 1/4 Sec 23	Sec_22 Twn 3N Rng 9W		
City State Zip Co Telephone No. (<u>601) 734 - 2253</u>	D'un D'uni	of Near t		
	Well Data			
Purpose of Well (circle one) Mome Industrial Public Supply Irrigation Fish Culture Other:				
Date well drilling started: $02/28/08$ Date well drilling completed: $02/28/08$				
f flowing, method of flow regulation: Valve	Other (describe)			
Static Water Level: <u>13</u> feet above or below (ci	rcle one) land surface Date measured:	07/28/08		
Method of Measurement (circle one) steel tape ele	ectric tape air line other:			
Hole depth: Well depth: /	Well grouted to a depth of	10feet		
Type of grout (circle one): Cement Bentonite	Mix	and the second second		
Casing length:feet Casing diameter:	2inches Type of casing:	pvC		
creen length: <u>10</u> feet Screen diameter:	2inches Type of screen:	pvc		
Screen slot size: 0-010 inches Setting depth	:: From <u>21</u> feet to <u>3</u>	feet		
ype of completion (circle all applicable): Gravel packed	Underreamed Telescoped Open	hole Natural Development		
Other (describ	e):			
op of lap pipe or reduction in casing:t	feet. If telescoped or more than one scre	en, describe on back of page		
ogs run (circle all applicable): No log run Electric Ga	mma Ray Density Sonic Neutron (Other: <u>Lisval</u>		
Name of organization running log(s):	· · · · · · · · · · · · · · · · · · ·			
certify that the well was drilled, constructed, and comp Department of Environmental Quality and/or the Mississ				
11 12 12 12)-790 Me	4. L.		
Print Name of Water Well Contractor and License No.	Signature of	Water Well Contractor		
		RECEIVE		
		MAR 1 9 2008		
		BY: OLWI		


- 83

If well telescopes please sketch below and show depths.



	Description of Formations Encountered	From	To 13
	while sa Gravel	13	31
1.1.1.1.1	······		

If more than one screen, show location of each on sketch

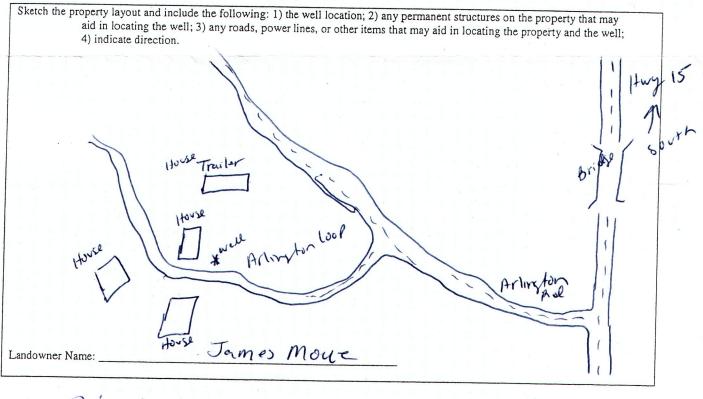

0

Signature of Water Well Contractor

MAR 1 9 2008 BY: OLWR

	STATE W	ELL REPORT			
County: \underline{perry} Permit #: $$ Driller: $\underline{H}, \underline{Williams}$ Date completed: $\underline{OF} 28 [0.3]$	Part 2 Pump Installer's Completion Report Mississippi Department of Environmental Quality Office of Land and Water Resources P.O. Box 10631 Jackson, MS 39289-0631 (601)961-5210 (601)354-6938 (fax)		For Office Use Only: Aquifer: Well #:		
This report should be prepared by the installation of pump.	e pump installer in de	ail and filed with the Departmen	at within 30 days of the		
Well Owner Information		Well Location			
Owner Name: James Mone		Latitude: 31° 12' 15" Longitude: 88° 53' 31" w			
Mailing Address: P.O. BOY 412 39423		Method of Lat/Long (circle one): Conventional Survey,			
75 Arlington Loop		USGS quad, Hand-held GPS Survey-grade GPS			
Begumont Ms. 39423		SW 1/4 SW 1/4 Sec 22 Twn 3N Rng 9W			
City State			Distance Direction Nearest Town		
Telephone No. (601)606-4102		<u>Les</u> Miles <u>SW</u> of <u>BEquinon</u> T			
Pump Type		Pow	ver Type		
Circle one			ccle one		
Air Lift (et)	Submersible	Diesel Engine Gasoline	e Engine Natural Gas		
Bucket Piston	Turbine	Electric Motor Hand	Tractor PTO		
Centrifugal Rotary	Flowing Well	Windmill Other (s	pecify):		
Other (specify):		Horse Power Rating of Motor: / h.p			
Date Pump Installed: $0 + / + 8 / 0 8$		Setting Depth: 30feet			
Rated Pump Capacity: Z	Gallons Per Minute	Number of Stages:			
Pump Test Data			suring Water Level		
Date Well Tested: 02/28/08		Cire	cle one		
Static Water Level (A): <u>13</u> Feet B	elow Land Surface	Air Line Electric Measu	bring Line Steel Tape		
Pumping Water Level (B):Feet Be	elow Land Surface	Other (specify):			
rawdown [(B) – (A)]:Feet Below Land Surface		For flowing well, measured shut in head:feet			
Test Pumping Rate:G	allons Per Minute	Well yieldedGPM with a drawdown of			
Duration of Pump Test (minimum 4 hours):	hours	feet after	hours of pumping		
I HEREBY CERTIFY that the above statement Head I. W. Jama Print Name of Pump Installer and License No.	0-790	f my knowledge.	aller		

RECEIVED MAR 1 9 2008 BY: OLWR