

STATE WELL REPORT

229

County: Perry
 Permit #: _____
 Driller: Josh Boone
 Date drilling completed: 4.19.19

**Part 1
 Driller's Log**
 Mississippi Department of Environmental Quality
 Office of Land and Water Resources
 P.O. Box 2309
 Jackson, MS 39225-2309
 (601)961-5555
 (601)961-5228 (fax)

For Office Use Only:

Well #: J101
 Aquifer: _____
 E-Log #: _____

State Law requires that this report be prepared by the license holder responsible for the work and filed with the Department at the above address within 30 days of completion of drilling of the well or borehole.

Well Owner Information <small>(Landowner if borehole is not for a water well)</small>	Well or Borehole Location
Owner Name: <u>Charles Herring</u>	Latitude: <u>31 12 49</u> Longitude: <u>88 52 43</u>
Mailing Address: <u>10 CR Herring Rd</u> <u>Beaumont MS 39423</u> City State Zip Code	Method of Lat/Long (check one): Conventional Survey _____, USGS quad _____, Hand-held GPS <input checked="" type="checkbox"/> , Survey-grade GPS _____
Telephone No. <u>(601) 788-7078</u>	<u>NW</u> ¼ <u>NE</u> ¼, Sec <u>22</u> T <u>3N</u> R <u>9W</u>
	<u>7</u> Miles <u>N</u> of <u>Beaumont</u> (Distance) (Direction) (Nearest Town)

Well / Borehole Data

Date drilling started: 4.19.19 Date drilling completed: 4.19.19 Hole depth: 185 Hole diameter: 7 1/4

Location of the source of any surface water used for drilling: running creek water

Method of dosing and volume of Chlorine used in drilling and development: granulated chlorine

Logs run (check all applicable): log run Electric Gamma Ray Density Sonic Neutron Other: _____

Name of organization running log(s): _____

Purpose of borehole (check one): Water Well Geotechnical/Geological Investigation Ground Source Heat Pump Seismic Survey Other (describe) _____

If drilling is not related to water well construction, skip the remainder of this block

Purpose of Well (check all applicable): Home Industrial Public Supply Irrigation Fish Culture

Other (describe): _____

If a flowing well, method of flow regulation: Valve _____ Other (describe) _____

Static Water Level: 155 feet above or below land surface (check one) Date measured: 4.19.19

Method of measurement (check one) Steel tape Electric tape Air line Other (describe): _____

Well depth: 185 Well grouted to a depth of: 10 feet Type of grout (check one) neat Cement Bentonite Mix

Casing length: 145 feet Casing diameter: 4 inches Type of casing: pvc

Screen length: 20 feet Screen diameter: 4 inches Type of screen: saw slot

Screen slot size: 8 inches Setting depth: From 145 feet to 185 feet

Type of completion (check all applicable) gravel packed Underreamed Open hole Natural Development

Other (describe): _____

Top of lap pipe or reduction in casing: _____ feet

If telescoped or more than one screen, describe on next page


RECEIVED
 MAY 21 2019
 BY OLWR

County: Perry
 Permit #: _____

For Office Use Only:
 Well #: 5101

The sketch below only required for water wells

If well telescopes, show depths on sketch.

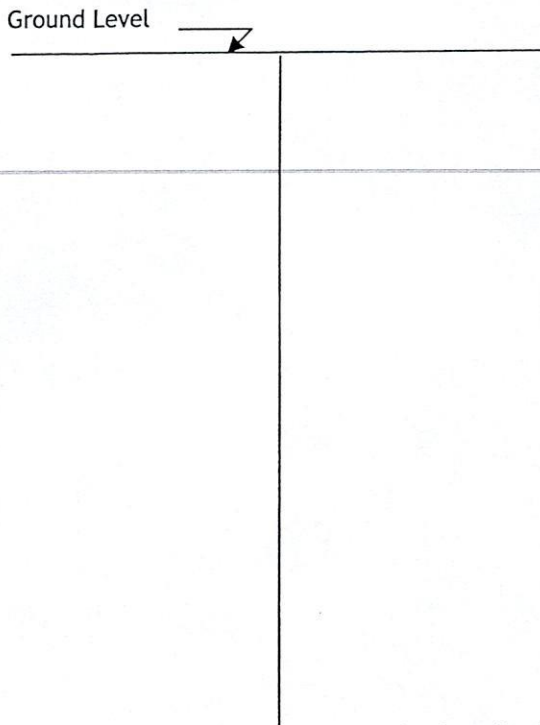


Description of formations encountered must be provided for all wells and boreholes, unless specifically exempted by regulations

Description of Formations Encountered	From (depth)	To (depth)
	Ground level	
Top Soil	0	2
Red clay	2	38
Sand	38	66
White clay	66	108
Sand & pebbles	108	185

If more than one screen, show location of each on sketch

Sketch the property layout and include the following:

- 1) the well location
- 2) any permanent structures on the property that may aid in locating the well
- 3) any roads, power lines, or other items that may aid in locating the property and the well
- 4) north arrow

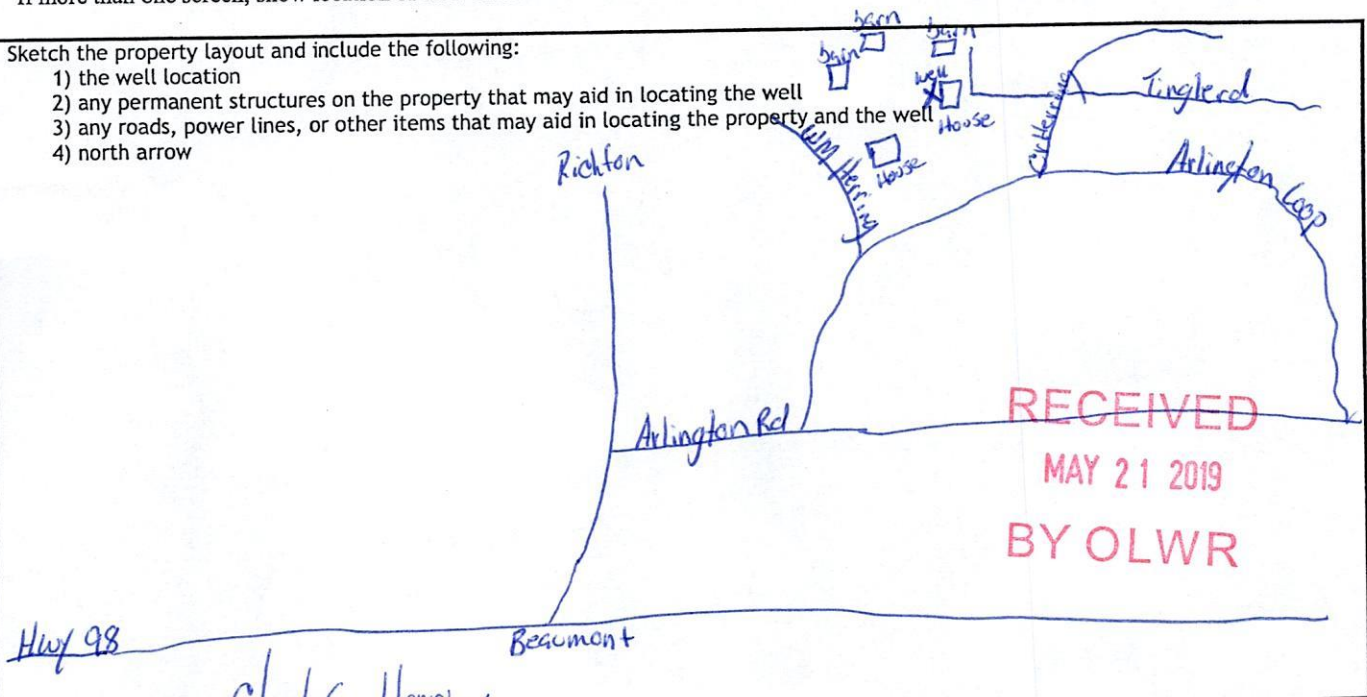

Landowner Name: Charles Herring

I HEREBY CERTIFY that the well/borehole was drilled, constructed, and completed in accordance with all applicable requirements of the Mississippi Department of Environmental Quality and the Mississippi Department of Health regulations, if applicable, and state laws.

Josh Boone 8683 4/19/19 Josh Boone
 Print Name of Responsible Licensee and License No. Date Signature of Licensee

STATE WELL REPORT

Part 2

Pump Installer's Completion Report
 Mississippi Department of Environmental Quality
 Office of Land and Water Resources
 P.O. Box 2309
 Jackson, MS 39225-2309
 (601)961-5210
 (601) 360-0535 (fax)

For Office Use Only:

Well #: J 101
 Aquifer: _____

County: Perry
 Permit #: _____
 Driller: Josh Boone
 Date completed: 4.19.19
Copy information from block on Part 1

This part of the report must be completed by a licensed water well contractor or a licensed pump installer. A copy of Part 1 of the report must be attached and both parts filed with the Department at the above address within 30 days of well completion.

Well Owner Information	Well Location
Owner Name: <u>Charles Herring</u>	Latitude: <u>31 12 49</u> Longitude: <u>88 52 43</u>
Mailing Address: <u>10 CR Heming Rd</u> <u>Beaumont MS 39423</u> City State Zip Code	Method of Lat/Long (check one): <u>53.77</u> Conventional Survey <u>48.02</u> USGS quad _____, Hand-held GPS <input checked="" type="checkbox"/> , Survey-grade GPS _____ <u>NW</u> 1/4 <u>NE</u> 1/4, Sec <u>22</u> T <u>3N</u> R <u>9W</u> <u>7</u> Miles <u>N</u> of <u>Beaumont</u> (Distance) (Direction) (Nearest Town)
Telephone No. <u>(601) 788-7078</u>	

Pump Type (check one)

Submersible Turbine Air Lift Centrifugal Flowing Well Jet Piston Rotary Other (describe): _____

Date Pump Installed: 4.19.19 Rated Pump Capacity: 18 Gallons Per Minute

Is This Pump (check one): New Repaired Replacement

Power Type (check one)

Electric Diesel Gasoline Natural Gas Tractor PTO Windmill Other (describe): _____

Horse Power Rating of Motor: 3/4 hp Setting Depth: 180 feet Number of Stages: 10

Pump Test Data for Non Flowing Well

Date Well Tested: 4.19.19 Duration of Pump Test (minimum 4 hours): 4 hours

Static Water Level (A): 155 Feet Below Land Surface Pumping Water Level (B): 173 Feet Below Land Surface

Drawdown [(B) - (A)]: 18 Feet Below Land Surface Test Pumping Rate: 18 Gallons Per Minute

Method of measurement (check one): Steel tape Electric tape Air line Other (describe): _____

Pump Test Data for Flowing Well

Measured shut in head: 155 feet.

Well yielded 18 GPM with a drawdown of 18 feet after 4 hours of pumping

Meter Installation

Meter Manufacturer: _____ Meter Serial Number: _____

Meter Model Number/Name: _____ Type of Meter: _____

Totalizer Register Unit and Multiplier Factor (AF x .001, gal x 1000, etc): _____

Installation Date: _____ Meter installed by: _____

Is This Meter (check one): New Repaired Replacement

RECEIVED
MAY 21 2019
BY OLWR

Important: By submitting the above information you are certifying that this meter was installed to manufacturer standards. For agricultural wells, a list of approved meters is on the MDEQ website.

I HEREBY CERTIFY that the above statements are true to the best of my knowledge.

Josh Boone 8683 4/19/19 _____
 Print Name of Pump Installer and License No. (if applicable) Date Signature of Pump Installer