

Perry
J 2001
4-14-76 ¹³⁰

MISSISSIPPI
 BOARD OF WATER COMMISSIONERS
 416 North State Street
 Jackson, Mississippi 39201

WATER WELL DRILLERS LOG

April 14 1976 Cochran Drilling Service Perry
 date well completed firm name county well located

LANDOWNER:

Mike Jordan

Box 2, Beaumont
 (mailing address)

WELL LOCATION:

sec. 27 T 3 ^(N) R 9 ^(E)
6 miles NE of Beaumont
 (distance) (direction) (nearest town)

WELL PURPOSE: house
 (home, irrigation, municipal, industrial)

WELL COMPLETION DATA:

- (1) diameter (inches) 2"
- (2) total depth (feet) 115'
- (3) static water level (feet) 70 ^(below) _(above) top of ground.
- (4) casing PVC, 110'
 (material) (depth)
2"
 (size) if telescope see back.
- (5) screen 5', 110'
 (length) (depth to top)
2", PVC
 (size) (material)
- (6) pump 1, 5 1/2
 (HP) (yield gpm)
elec
 (type power)
- (7) electric log no
 (yes or no)
 (organization running log)
- (8) how well bottom plugged valve

description of formations encountered

from to


<u>Top soil</u>	<u>0</u>	<u>3</u>
<u>red clay</u>	<u>3</u>	<u>18</u>
<u>red sand</u>	<u>18</u>	<u>27</u>
<u>gray clay</u>	<u>27</u>	<u>33</u>
<u>white clay</u>	<u>33</u>	<u>49</u>
<u>red sand</u>	<u>49</u>	<u>76</u>
<u>white sand</u>	<u>76</u>	<u>115</u>

DRILLERS REMARKS:

MAY 19 1976

If well telescopes please sketch and show depths.

GROUND LEVEL

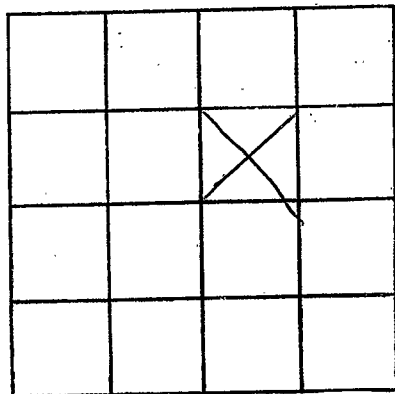

SECTION 22

Please indicate well location X.

ADDITIONAL INFORMATION

If more than one screen, show locations of each on sketch.