

C. P. CLARK

WATER WELL DRILLING

MISSISSIPPI BOARD OF WATER COMMISSIONERS
ROUTE 2
416 North State Street
JACKSON, MISSISSIPPI 39201
LAUREL, MISS. 39440

WATER WELL DRILLERS LOG

Perry
J 2003
11/15/77

11/15 1977 date well completed
C. P. Clark firm name
Perry county well located

LANDOWNER: Leo Jackson
Beaumont Miss.
(mailing address)

WELL LOCATION:
sec. 21 T 30 N R 9 E
1 3/4 miles N.W. of Beaumont
(distance) (direction) (nearest town)

WELL PURPOSE:
(home, irrigation, municipal, industrial)

- WELL COMPLETION DATA:
- (1) diameter (inches) 2
 - (2) total depth (feet) 194
 - (3) static water level (feet) 10 below top of ground.
 - (4) casing Galv. 189 (material) (depth)
 - (size) if telescope see back.
 - (5) screen 5 189 (length) (depth to top)
 - 1 1/4 Solid S.S. (size) (material)
 - (6) pump None 25 h.p.m. (HP) (yield gpm) w/ air
 - (type power)
 - (7) electric log No (yes or no)
 - (organization running log)
 - (8) how well bottom plugged B.W.U.


description of formations encountered	from	to
Clay	0	7
Clay	0	7
Sand	7	47
Blue Clay	47	80
Sand + Gravel	80	207

RECEIVED
JAN 20 1978
MISS. BD. OF WATER COMMISSIONERS

DRILLERS REMARKS: Customer to set own pump

If well telescopes please sketch and show depths.

GROUND LEVEL

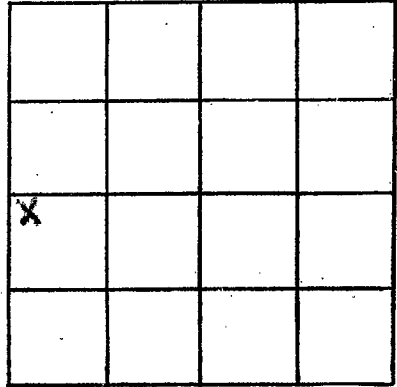

SECTION 21

Please indicate well location X.

ADDITIONAL INFORMATION

If more than one screen, show locations of each on sketch.