

Perry
 J 2004
 7/5/77

MISSISSIPPI
 BOARD OF WATER COMMISSIONERS
 416 North State Street
 Jackson, Mississippi 39201

WATER WELL DRILLERS LOG

July 5 1977 *Cochran Drilling Service Perry*
 date well completed firm name county well located


LANDOWNER:	description of formations encountered	from	to
<i>Maria Merwin</i>			
<i>PO Box New Augusta</i> (mailing address)	<i>Top soil</i>	<i>0</i>	<i>2</i>
	<i>red clay</i>	<i>2</i>	<i>8</i>
	<i>red sand</i>	<i>8</i>	<i>13</i>
	<i>gray clay</i>	<i>13</i>	<i>19</i>
	<i>sand</i>	<i>19</i>	<i>50</i>
WELL LOCATION: sec. <i>19</i> T. <i>3</i> N. R. <i>9</i> E <i>73 1/2</i> miles <i>N-W</i> of <i>Beaumont</i> (distance) (direction) (nearest town)			
WELL PURPOSE: <i>home</i> (home, irrigation, municipal, industrial)			
WELL COMPLETION DATA: (1) diameter (inches) <i>2"</i> (2) total depth (feet) <i>50'</i> (3) static water level (feet) <i>12</i> ^{below} / _{above} top of ground. (4) casing <i>PVC</i> , <i>45'</i> (material) (depth) <i>_____</i> If telescope see back. (size) (5) screen <i>5'</i> , <i>45'</i> (length) (depth to top) <i>2"</i> , <i>PVC</i> (size) (material) (6) pump <i>1</i> , <i>6</i> (HP) (yield gpm) <i>Elect</i> (type power) (7) electric log <i>no</i> (yes or no) <i>_____</i> (organization running log) (8) how well bottom plugged <i>valve</i>			
DRILLERS REMARKS:			

RECEIVED
 AUG 24 1977

MISS. BD. OF WATER COMM.

If well telescopes please sketch and show depths.

GROUND LEVEL

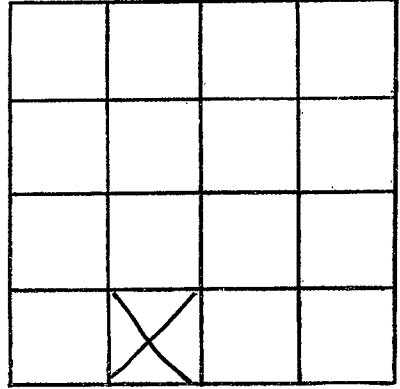

SECTION 19

Please indicate well location X.

ADDITIONAL INFORMATION

If more than one screen, show locations of each on sketch.