

Perry  
 J 2005  
 7/27/77

MISSISSIPPI C. P. CLARK  
 BOARD OF WATER COMMISSIONERS WELL DRILLING  
 416 North State Street ROUTE 2  
 Jackson, Mississippi 39201 LAUREL, MISS. 39440

WATER WELL DRILLERS LOG

7/27 1977 C.P. Clark Perry  
 date well completed firm name county well located


LANDOWNER: <u>W. R. Westmoreland</u> <u>Beaumont Miss</u>	description of formations encountered	from	to
(mailing address)	<u>Sand</u> <del>Clay</del>	<u>8</u>	<u>91</u>
<b>WELL LOCATION:</b>			
sec. <u>8</u> T. <u>3</u> (N) R. <u>9</u> (E) <u>3 1/2</u> miles <u>N</u> of <u>Beaumont</u> (distance) (direction) (nearest town)			
<b>WELL PURPOSE:</b> <u>Home</u> (home, irrigation, municipal, industrial)			
<b>WELL COMPLETION DATA:</b>			
(1) diameter (inches) <u>2</u>			
(2) total depth (feet) <u>89</u>			
(3) static water level (feet) <u>23</u> below above top of ground.			
(4) casing <u>Galvneon</u> <u>84</u> (material) (depth)			
(size) if telescope see back.			
(5) screen <u>5</u> <u>84</u> (length) (depth to top)			
<u>1 1/4</u> <u>Solid S.S 006</u> (size) (material)			
(6) pump <u>1</u> <u>12</u> (HP) (yield gpm)			
<u>2200</u> <u>10</u> (type power)			
(7) electric log (yes or no) _____			
(organization running log)			
(8) how well bottom plugged <u>BWS</u>			
DRILLERS REMARKS: <u>Set 12A</u> <u>put @ 42ft 11 ft. Sta</u> <u>Wells Pump 2 stage</u>			

RECEIVED  
 OCT 18 1977

WATER CLAIMED

If well telescopes please sketch and show depths.

GROUND LEVEL

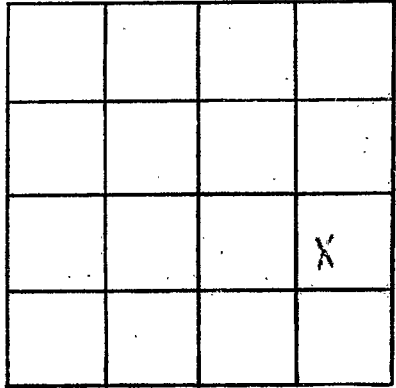

SECTION 7

Please indicate well location X.

ADDITIONAL INFORMATION

Lined area for additional information.

If more than one screen, show locations of each on sketch.

*Handwritten notes and signature*