

Perry
J 2006
11-28-79

MISSISSIPPI
 BOARD OF WATER COMMISSIONERS
 416 North State Street
 Jackson, Mississippi 39201

WATER WELL DRILLERS LOG

11-28-79 19 Tom Hightch Perry
 date well completed firm name county well located

LANDOWNER: Peter B. Breland
P.O. 1, Box 247A
Beaumont, MS (mailing address)
 WELL LOCATION:
 sec 29 T 3 N R 9 E
4 miles N of Beaumont
 (distance) (direction) (nearest town)

description of formations encountered	from	to
<u>top soil</u>	<u>0</u>	<u>1</u>
<u>Clay</u>	<u>1</u>	<u>190</u>
<u>Sand</u>	<u>190</u>	<u>195</u>
<u>Chalk</u>	<u>195</u>	<u>205</u>
<u>Sand</u>	<u>305</u>	<u>260</u>

WELL PURPOSE: Home
 (home, irrigation, municipal, industrial)


WELL COMPLETION DATA:
 (1) diameter (inches) 2"
 (2) total depth (feet) 260'
 (3) static water level (feet) 60' below top of ground.
 (4) casing Plastic, 240'
 (material) (depth)
2" If telescope see back.
 (size)
 (5) screen 20', 240'
 (length) (depth to top)
2", Plastic
 (size) (material)
 (6) pump _____ (HP) _____ (yield gpm)
Electric
 (type power)
 (7) electric log NO
 (yes or no)
NONE
 (organization running log)
 (8) how well bottom plugged B.W.L.

DRILLERS REMARKS: _____

DEPT. OF NATURAL RESOURCES
 BUREAU OF LAND & WATER RESOURCES
 JAN 7 1980
 RECEIVED

If well telescopes please sketch and show depths.

GROUND LEVEL

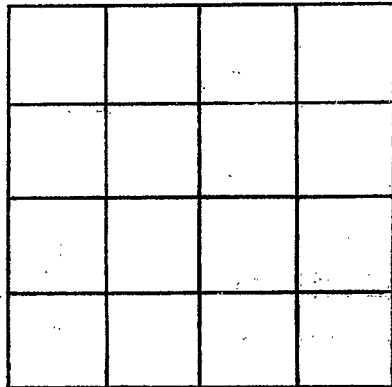

SECTION _____

Please indicate well location X.

ADDITIONAL INFORMATION

If more than one screen, show locations of each on sketch.