

PERRY  
J 2007  
4-4-80

MISSISSIPPI  
BOARD OF WATER COMMISSIONERS  
416 North State Street  
Jackson, Mississippi 39201

WATER WELL DRILLERS LOG


April 4 1980 Roy West Drig Perry  
date well completed firm name county well located

LANDOWNER: J.R. Bolton	description of formations encountered		from	to
Box 95 New Augusta	CLAY		0	30
	SAND		30	35
(mailing address)				
<b>WELL LOCATION:</b>				
sec. 31 T 3 N R 9 E				
3 miles W of Berclair				
(distance) (direction) (nearest town)				
<b>WELL PURPOSE:</b> Home				
(home, irrigation, municipal, industrial)				
<b>WELL COMPLETION DATA:</b>				
(1) diameter (inches) 2				
(2) total depth (feet) 35'				
(3) static water level (feet) 17' below top of ground.				
(4) casing PVC 30'				
(material) (depth)				
(size) if telescope see back.				
(5) screen 5' 30'				
(length) (depth to top)				
1/4" stainless steel				
(size) (material)				
(6) pump 5 6				
(HP) (yield gpm)				
REA				
(type power)				
(7) electric log NO				
(yes or no)				
(organization running log)				
(8) how well bottom plugged WASH UNLVE				
	APR 16 1980			
DRILLERS REMARKS:	RECEIVED			

DEPT. OF NATURAL RESOURCES  
BUREAU OF LAND & WATER RESOURCES

If well telescopes please sketch and show depths.

GROUND LEVEL

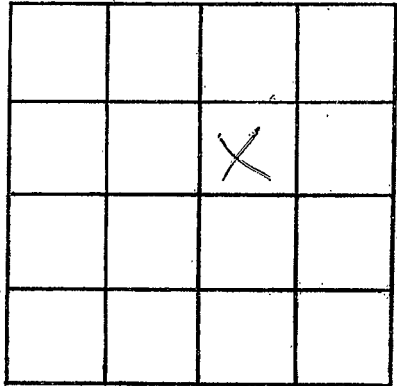

SECTION \_\_\_\_\_

Please indicate well location X.

ADDITIONAL INFORMATION

If more than one screen, show locations of each on sketch.