

MISSISSIPPI DEPARTMENT OF NATURAL RESOURCES

Bureau of Land and Water Resources

Southport Mall

P.O. Box 10631

Jackson, Mississippi 39209

WATER WELL DRILLERS LOG

4

Perry
J 2008
9-3-81

9-3-81 → Cochrane Drilling Perry
date well completed firm name county well located

LANDOWNER:
George S. Loester
Rt 1 Berment
(mailing address)

WELL LOCATION:
sec. 27 T 30 S R 9 E
5 miles N.E. of Berment
(distance) (direction) (nearest town)

WELL PURPOSE:
Home (none, irrigation, municipal, industrial)

WELL COMPLETION DATA:

- (1) diameter (inches) 2 1/2"
- (2) total depth (feet) 480'
- (3) static water level (feet) below top of ground.
- (4) casing P.V.C. 470' (material) (depth)
if telescope see back.
- (5) screen 10' 470' (length) (depth to top)
2" P.V.C. (size) (material)
- (6) pump (HP) (yield gpm)
(type power)
- (7) electric log (yes or no)
(organization running log)
- (8) how well bottom plugged w/c

description of formations encountered	from	to
Top Soil	0	2
gray clay	2	6
Brown clay	6	14
sand	14	28
Blue clay	28	82
sand	82	120
Blue clay	120	260
sand	260	290
Blue clay	290	380
Blue shale	380	392
Blue clay	392	420
sand	420	480

DRILLERS REMARKS:


DEPT. OF NATURAL RESOURCES
BUREAU OF LAND & WATER RESOURCES

OCT 19 1981

RECEIVED

If well telescopes please sketch and show depths.

GROUND LEVEL

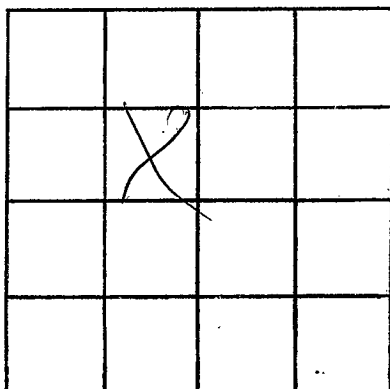

SECTION 27

Please indicate well location X.

ADDITIONAL INFORMATION

If more than one screen,
show locations of each on sketch.