

MISSISSIPPI DEPARTMENT OF NATURAL RESOURCES

Bureau of Land and Water Resources

Southport Mall

P.O. Box 10631

Jackson, Mississippi 39209

WATER WELL DRILLERS LOG

Perry  
J 2009  
9-7-81

9-7-81 Cochran Drilling Perry  
date well completed firm name county well located

LANDOWNER:	description of formations encountered	from	to
Jimmy HERRIN	TOP SOIL	0	2
RT 1 Beauvoir (mailing address)	Red clay	2	8
	red sand	8	14
WELL LOCATION:	GRAY clay	4	23
sec. <u>26</u> T <u>30</u> N R <u>9</u> E	sand	23	30
<u>5</u> miles <u>N.E.</u> of <u>Beaumont</u>	Blue clay	30	125
(distance) (direction) of (nearest town)	sand	125	132
WELL PURPOSE: <u>home</u>	Blue clay	132	182
(home) Irrigation, municipal, industrial	sand	182	200

- WELL COMPLETION DATA:
- (1) diameter (inches) 2"
  - (2) total depth (feet) 200'
  - (3) static water level (feet) 80 below above top of ground.
  - (4) casing PVC, 190' (material) (depth)
  - 2" if telescope see back. (size)
  - (5) screen 10', 190' (length) (depth to top)
  - 2", PVC (size) (material)
  - (6) pump (HP) (yield gpm)
  - (type power)
  - (7) electric log (yes or no)
  - (organization running log)
  - (8) how well bottom plugged valve

DRILLERS REMARKS:


DEPT. OF NATURAL RESOURCES  
BUREAU OF LAND & WATER RESOURCES

OCT 19 1981

RECEIVED

If well telescopes please sketch and show depths.

GROUND LEVEL

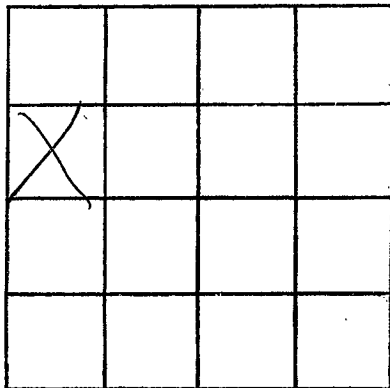

SECTION 26

Please indicate well location X.

ADDITIONAL INFORMATION

If more than one screen, show locations of each on sketch.

RECEIVED  
AUG 14 8 10 19 81