

MISSISSIPPI DEPARTMENT OF NATURAL RESOURCES

Bureau of Land and Water Resources

Southport Mall

P.O. Box 10631

Jackson, Mississippi 39209

WATER WELL DRILLERS LOG

Perry
J 2010
9-4-81

Sept 4 1981 Cochean Drilling Perry
 date well completed firm name county well located

LANDOWNER:	description of formations encountered	from	to
Dewitt Byrd	TOP Soil	0	2
Rt 1 Beaumont (mailing address)	gray clay	2	8
	Brown clay	8	16
	sand	16	30
	Blue clay	30	140
	sand	140	180
	Blue clay	180	285
	sand	285	310
	Blue clay	310	375
	sand	375	380
	Blue clay	380	415
	sand	415	470

LANDOWNER:
 Dewitt Byrd
 Rt 1 Beaumont
 (mailing address)

WELL LOCATION:
 sec. 27 T. 30 S. R. 9 E. W. 1
 5 miles N.E. of Beaumont
 (distance) (direction) (nearest town)

WELL PURPOSE:
 (home, irrigation, municipal, industrial) hor

WELL COMPLETION DATA:

(1) diameter (inches) 2"

(2) total depth (feet) 470'

(3) static water level (feet) 272 below/above top of ground.

(4) casing PVC 460'
 (material) (depth)
— if telescope see back.
 (size)

(5) screen 10" 460'
 (length) (depth to top)
2" PVC
 (size) (material)

(6) pump — —
 (HP) (yield gpm)
—
 (type power)

(7) electric log —
 (yes or no)
—
 (organization running log)

(8) how well bottom plugged valve

DRILLERS REMARKS:


DEPT. OF NATURAL RESOURCES
 BUREAU OF LAND & WATER RESOURCES

OCT 19 1981

RECEIVED

If well telescopes please sketch and show depths.

GROUND LEVEL

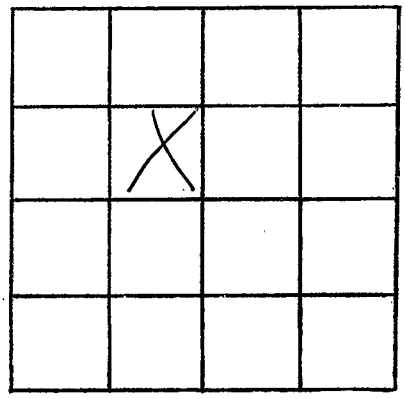

SECTION 27

Please indicate well location X.

ADDITIONAL INFORMATION

Lined area for additional information.

If more than one screen, show locations of each on sketch.